

STONE  
C60  
12-17-73

MISSISSIPPI  
BOARD OF WATER COMMISSIONERS  
416 North State Street  
Jackson, Mississippi 39201

CODED

WATER WELL DRILLERS LOG

12-17-73 date well completed 1923 Darnell Anderson firm name Stone county well located

LANDOWNER:  
Charles L. Blanch  
(mailing address)  
WELL LOCATION:  
sec. 17 T. 2 S. R. 11 E. W. 4  
0.1 miles N-E of Wilcox  
(distance) (direction) (nearest town)

| description of formations encountered | from | to  |
|---------------------------------------|------|-----|
| Top Soil                              | 0    | 3   |
| Pink Clay                             | 3    | 12  |
| Fine Sand                             | 12   | 84  |
| Coarse Sand                           | 84   | 105 |

WELL PURPOSE: HOME  
(home, irrigation, municipal, industrial)

WELL COMPLETION DATA:  
(1) diameter (inches) 2"  
(2) total depth (feet) 105'  
(3) static water level (feet) 46' below top of ground.  
(4) casing Plastic, 100' (material) (depth)  
If telescope see back.  
(5) screen 5' 100' (length) (depth to top)  
2" Plastic (size) (material)  
(6) pump 1 12 (HP) (yield gpm)  
Elect (type power)  
(7) electric log NO (yes or no)  
(organization running log)  
(8) how well bottom plugged Back wash valve


CODED

RECEIVED  
JAN 1 1974

DRILLERS REMARKS:

If well telescopes please sketch and show depths.

GROUND LEVEL

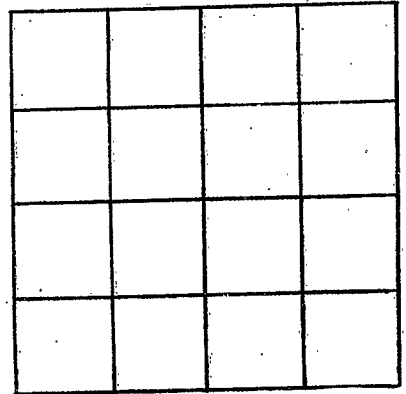

SECTION \_\_\_\_\_

Please indicate well location X.

ADDITIONAL INFORMATION

If more than one screen, show locations of each on sketch.