

STONE  
 C61  
 1-24-74

MISSISSIPPI  
 BOARD OF WATER COMMISSIONERS  
 416 North State Street  
 Jackson, Mississippi 39201

CODED

WATER WELL DRILLERS LOG

1-24 1971 Pernell Anderson Stone  
 date well completed firm name county well located

LANDOWNER:  
Crab B. Rellend  
Rt 1, Wiggins  
 (mailing address)

description of formations encountered	from	to
<u>Top Soil</u>	<u>0</u>	<u>4</u>
<u>Red Clay</u>	<u>4</u>	<u>45</u>
<u>Course Sand</u>	<u>45</u>	<u>85</u>

WELL LOCATION:  
 sec. 35 T. 2 N. R. 11 E.  
 S. W.  
5 miles E of Wiggins  
 (distance) (direction) (nearest town)

WELL PURPOSE: HOME  
 (home, irrigation, municipal, industrial)

WELL COMPLETION DATA:

(1) diameter (inches) 2"

(2) total depth (feet) 85'

(3) static water level (feet) 45' below above top of ground.

(4) casing Plastic, 80'  
 (material) (depth)  
 if telescope see back.  
 (size)

(5) screen 5', 80'  
 (length) (depth to top)  
2", Plastic  
 (size) (material)


(6) pump 1, 9  
 (HP) (yield gpm)  
Electric  
 (type power)

(7) electric log no  
 (yes or no)

(organization running log)

(8) how well bottom plugged Back well valve

CODED

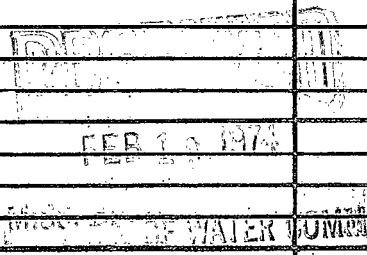

DRILLERS REMARKS:

