

**MISSISSIPPI  
BOARD OF WATER COMMISSIONERS**  
416 North State Street  
Jackson, Mississippi 39201

**CODED**

**WATER WELL DRILLERS LOG**

**STONE**  
**C 62**  
**1-22-74**

1-22-74  
date well completed

1974 Parnell Anderson  
firm name

Stone  
county well located

**LANDOWNER:**  
Ruby L Saach  
Rt 1 Box 4 Wigg  
(mailing address)

description of formations encountered	from	to
Top Soil	0	4
Pink clay	4	24
White clay	24	60
Blue clay	60	92
Coarse sand	92	107

**WELL LOCATION:**  
Sec 36 T 2 S R 11 W  
5 miles E of Wigg  
(distance) (direction) (nearest town)

**WELL PURPOSE:** HOME  
(home, irrigation, municipal, industrial)

- WELL COMPLETION DATA:**
- (1) diameter (inches) 2"
  - (2) total depth (feet) 107'
  - (3) static water level (feet) 48' below above top of ground.
  - (4) casing Plastic, 102'  
(material) (depth)
  - \_\_\_\_\_ if telescope see back.  
(size)
  - (5) screen 5', 102'  
(length) (depth to top)  
3", Plastic  
(size) (material)
  - (6) pump 1, 10  
(HP) (yield gpm)  
Electric  
(type power)
  - (7) electric log no  
(yes or no)
  - \_\_\_\_\_ (organization running log)
  - (8) how well bottom plugged  
Back wash valve


**CODED**

**DRILLERS REMARKS:**

FEB 10 1974  
MISS. BOARD OF WATER COMM

If well telescopes please sketch and show depths.

GROUND LEVEL

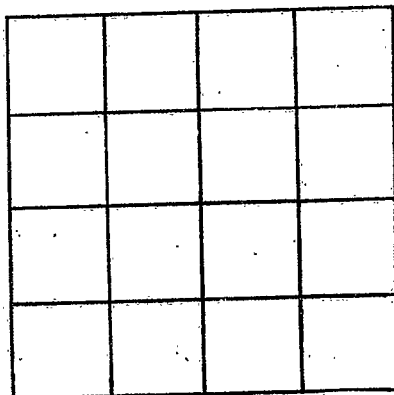

SECTION \_\_\_\_\_

Please indicate well location X.

ADDITIONAL INFORMATION

If more than one screen,  
show locations of each on sketch.