

STONE
C 63
2-4-74

MISSISSIPPI
BOARD OF WATER COMMISSIONERS
416 North State Street
Jackson, Mississippi 39201

CODEL

WATER WELL DRILLERS LOG

2-4 1974 Parnell Anderson Stone
date well completed firm name county well located

LANDOWNER:
Ned Taylor
Rt 1 Wiggins
(mailing address)

description of formations encountered	from	to
<u>Top soil</u>	<u>0</u>	<u>3</u>
<u>Red clay</u>	<u>3</u>	<u>39</u>
<u>Fine sand</u>	<u>39</u>	<u>42</u>
<u>Course sand</u>	<u>42</u>	<u>60</u>

WELL LOCATION:
sec. 9 T. 2 S. R. 11 E.
4 miles N.E. of Wiggins
(distance) (direction) (nearest town)

WELL PURPOSE: HOME
(home, irrigation, municipal, industrial)

WELL COMPLETION DATA:

(1) diameter (inches) 2"

(2) total depth (feet) 60'

(3) static water level (feet) 35' below top of ground.

(4) casing Plastic 55'
(material) (depth)

_____ if telescope see back.
(size)

(5) screen 5' 5-5'
(length) (depth to top)

2" Plastic
(size) (material)

(6) pump 1/2 5
(HP) (yield gpm)


Elect
(type power)

(7) electric log no
(yes or no)

_____ (organization running log)

(8) how well bottom plugged? Backwash Valve

CODEL

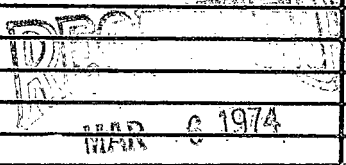

MISS. BD. OF WATER COMMISSIONERS

DRILLERS REMARKS:

