

STONE
 C 66
 4-5-74

MISSISSIPPI
 BOARD OF WATER COMMISSIONERS
 416 North State Street
 Jackson, Mississippi 39201

WATER WELL DRILLERS LOG

4-5 1974 Pernell Anderson Stone
 date well completed firm name county well located

LANDOWNER:
John Lathrie
P.O. Box 1009
 (mailing address)

description of formations encountered	from	to
<u>Top Soil</u>	<u>0</u>	<u>4</u>
<u>Red Clay</u>	<u>4</u>	<u>21</u>
<u>Whip Clay</u>	<u>21</u>	<u>35</u>
<u>Fine Sand</u>	<u>35</u>	<u>60</u>
<u>Blue Clay</u>	<u>60</u>	<u>85</u>
<u>Coarse Sand</u>	<u>85</u>	<u>105</u>

WELL LOCATION:
 sec 27 T 2 R 11
3 miles E of Wiggins
 (distance) (direction) (nearest town)

WELL PURPOSE: HOME
 (home, irrigation, municipal, industrial)

- WELL COMPLETION DATA:
- (1) diameter (inches) 2"
 - (2) total depth (feet) 105'
 - (3) static water level (feet) 52' below top of ground
 - (4) casing Plastic, 100'
 (material) (depth)
 (size) if telescope see back.
 - (5) screen 5', 100'
 (length) (depth to top)
2', Plastic
 (size) (material)
 - (6) pump ?, 10
 (HP) (yield gpm)
Elect
 (type power)
 - (7) electric log NO
 (yes or no)
 - (8) how well bottom plugged
Back with water


DRILLERS REMARKS:

NOTED

MAY 10 1974

If well telescopes please sketch and show depths.

GROUND LEVEL

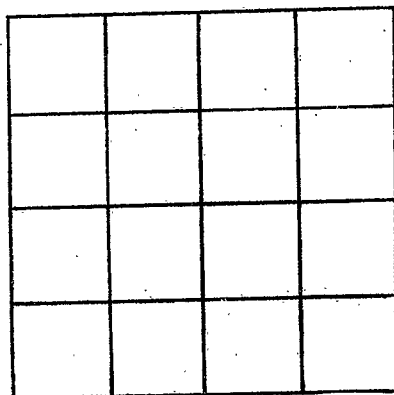

SECTION: _____

Please indicate well location X.

ADDITIONAL INFORMATION

If more than one screen, show locations of each on sketch.