

STONE

C 67

4-18-74

MISSISSIPPI BOARD OF WATER COMMISSIONERS
416 North State Street
Jackson, Mississippi 39201

CODED

WATER WELL DRILLERS LOG

4-18

1974 Darnell Anderson Stone

date well completed

firm name

county well located

LANDOWNER:

Wayne Davis
Rt 2 Wiggins
(mailing address)

description of formations encountered

from to

Top Soil	0	3
Pink Clay	3	20
a streak of Clay + a streak of sand from	20	90
coarse sand	90	104

WELL LOCATION:

sec. 32 T. 2 S. R. 11 E. S. 34
3 3/4 miles (distance) E of Wiggins (nearest town)

WELL PURPOSE: HOME
(home, irrigation, municipal, industrial)

WELL COMPLETION DATA:

- (1) diameter (inches) 2"
- (2) total depth (feet) 104'
- (3) static water level (feet) 45' below top of ground
- (4) casing Plastic, 99' (material) (depth)
- (5) screen 5' 99' (length) (depth to top)
2' Plastic (size) (material)
- (6) pump 1 (HP) 9 (yield gpm)
Elect (type power)
- (7) electric log no (yes or no)

CODED


(organization running log)

(8) has well bottom plugged
Back wash valve

DRILLERS REMARKS:

If well telescopes please
sketch and show depths.

GROUND LEVEL

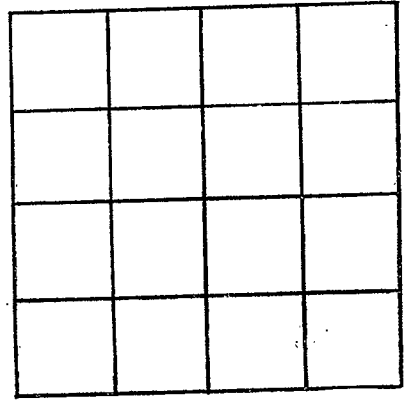

SECTION _____

Please indicate well location X.

ADDITIONAL INFORMATION

If more than one screen,
show locations of each on sketch.