

STONE

C68

4-17-74

MISSISSIPPI  
 BOARD OF WATER COMMISSIONERS  
 416 North State Street  
 Jackson, Mississippi 39201

CODED

WATER WELL DRILLERS LOG

4-17  
date well completed

1974 Parnell Anderson Stone  
firm name

county well located

LANDOWNER:

Jerry Lott  
Rt 2 Wiggins  
(mailing address)

description of formations encountered

from to

Top Soil	0	3
Red Clay	3	30
Fine Sand	30	65
Coarse Sand	65	85

WELL LOCATION:

sec. 23 T. 2 R. 11 E Wiggins  
4 miles (distance) E of (direction) (nearest town)

WELL PURPOSE: HOME  
(home, irrigation, municipal, industrial)

WELL COMPLETION DATA:

- (1) diameter (inches) 2"
- (2) total depth (feet) 85'
- (3) static water level (feet) 40' below top of ground
- (4) casing Plastic 80' (material) (depth)
- (size) if telescope see back.
- (5) screen 5' 80' (length) (depth to top)  
2" Plastic (size) (material)
- (6) pump 1 10 (HP) (yield gpm)  
Elect (type power)
- (7) electric log no (yes or no)

CODED

(organization running log)

(8) has well bottom plugged Back wash valve


DRILLERS REMARKS:

MAY 16 1974

MISS. SO. OF WATER COMPANY

If well telescopes please sketch and show depths.

GROUND LEVEL

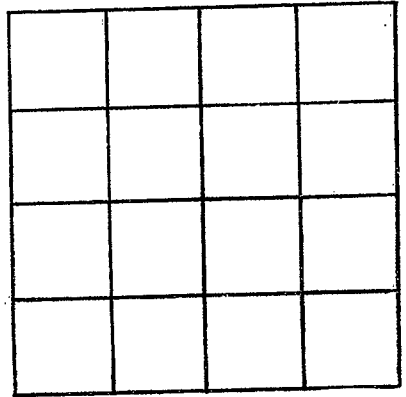

SECTION \_\_\_\_\_

Please indicate well location X.

ADDITIONAL INFORMATION

If more than one screen,  
show locations of each on sketch.