

STONE
C 69
4-19-74

MISSISSIPPI
BOARD OF WATER COMMISSIONERS
416 North State Street
Jackson, Mississippi 39201

CODED

WATER WELL DRILLERS LOG

4-19 1974
date well completed

74 Darnell Henderson
firm name

Stone
county well located

LANDOWNER:

J. A. O Neal
Rt 2 W Legg
(mailing address)

description of formations
encountered

from to

Top Soil 0 3
white clay 3 81
Coarse sand 81 103

WELL LOCATION:

sec. 17 T 2 R 11
3 miles NE of Wegg
(distance) (direction) (nearest town)

WELL PURPOSE: HOME
(home, irrigation, municipal, industrial)

WELL COMPLETION DATA:

- (1) diameter (inches) 2"
(2) total depth (feet) 103
(3) static water level (feet) 35' below top of ground
(4) casing Plastic 98'
(material) (depth)

CODED

- If telescope see back.
(size)
(5) screen 5' 98'
(length) (depth to top)
2" Plastic
(size) (material)

- (6) pump 1 12
(HP) (yield gpm)
Elect
(type power)

- (7) electric log no
(yes or no)

(organization running log)

- (8) how well bottom plugged
Back with valve


DRILLERS REMARKS:

MAY 1 1974

MISSISSIPPI WATER COMMISSION

If well telescopes please sketch and show depths.

GROUND LEVEL

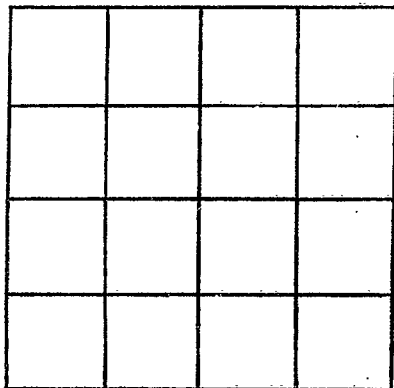

SECTION _____

Please indicate well location X.

ADDITIONAL INFORMATION

If more than one screen, show locations of each on sketch.