

STONE

C 70

4-24-74

MISSISSIPPI  
 BOARD OF WATER COMMISSIONERS  
 416 North State Street  
 Jackson, Mississippi 39201

CODED

WATER WELL DRILLERS LOG

4-24 1974  
date well completed

Parnell Anderson Stone  
firm name

Stone  
county well located

LANDOWNER:

Vernon Hinton

Rt 2 Wiggins  
(mailing address)

WELL LOCATION:

sec. 27 T. 28 R. 11  
 1/2 miles E of Wiggins  
 (distance) (direction) (nearest town)

WELL PURPOSE: HOME  
 (home, irrigation, municipal, industrial)

WELL COMPLETION DATA:

- (1) diameter (inches) 2"
- (2) total depth (feet) 78'
- (3) static water level (feet) 40' below top of ground.
- (4) casing Plastic, 73' (material) (depth)

if telescope see back. (size)

- (5) screen 5' 73' (length) (depth to top)
- 2" Plastic (size) (material)

- (6) pump 1 (HP) 9 (yield gpm)
- Elect (type power)

- (7) electric log no. (yes or no)

(organization running log)

- (8) from well bottom plugged Back wash valve

description of formations encountered

description of formations encountered	from	to
Top Soil	0	4
Red Clay	4	38
Finl Sand	38	60
Coarse Sand	60	78


CODED

DRILLERS REMARKS:

MISS. B... CORP.

If well telescopes please sketch and show depths.

GROUND LEVEL

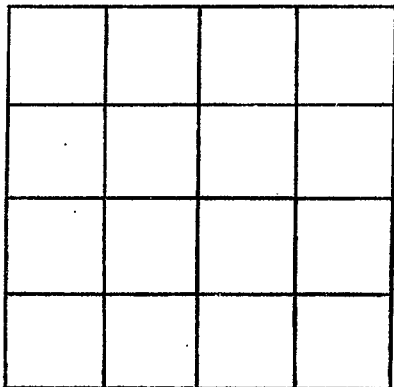

SECTION \_\_\_\_\_

Please indicate well location X.

ADDITIONAL INFORMATION

If more than one screen,  
show locations of each on sketch.