

**MISSISSIPPI
BOARD OF WATER COMMISSIONERS**
416 North State Street
Jackson, Mississippi 39201

WATER WELL DRILLERS LOG

CODED

STONE
C71
5-28-74

5-28-74 date well completed 1974 Parrell Anderson firm name Stone county well located

LANDOWNER:
Garry Earl Rogers
Rt 1 Wegg
(mailing address)

description of formations encountered	from	to
<u>Top Soil</u>	<u>0</u>	<u>3</u>
<u>Fluvial Sand</u>	<u>3</u>	<u>40</u>
<u>Coarse Sand</u>	<u>40</u>	<u>61</u>

WELL LOCATION:
sec. 4 T. 2 S. R. 11 W.
14 miles N-E of Wegg
(distance) (direction) (nearest town)

WELL PURPOSE: HOME
(home, irrigation, municipal, industrial)

WELL COMPLETION DATA:

(1) diameter (inches) 2"

(2) total depth (feet) 61'

(3) static water level (feet) 30' below top of ground.

(4) casing Plastic 56'
(material) (depth)

_____ if telescope see back.
(size)

(5) screen 5' 56'
(length) (depth to top)

2" Plastic
(size) (material)

(6) pump 1 8
(HP) (yield gpm)

Electric
(type power)

(7) electric log no
(yes or no)

_____ (organization running log)

(8) how well bottom plugged Plugged


CODED

REGISTERED
LOG
JUN - 6 1974

DRILLERS REMARKS:

If well telescopes please sketch and show depths.

GROUND LEVEL

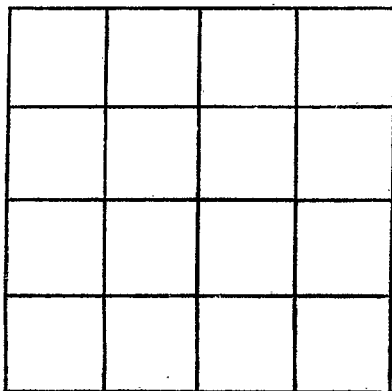

SECTION _____

Please indicate well location X.

ADDITIONAL INFORMATION

If more than one screen,
show locations of each on sketch.