

STONE
C 72
6-24-74

MISSISSIPPI
BOARD OF WATER COMMISSIONERS
416 North State Street
Jackson, Mississippi 39201

CODED

WATER WELL DRILLERS LOG

6-24
date well completed

1974 Panell Anderson
firm name

Stone
county well located

LANDOWNER:

David Rayburn
Rt 1 W Eggs
(mailing address)

description of formations
encountered

	from	to
<u>Top Soil</u>	<u>0</u>	<u>3</u>
<u>white clay</u>	<u>3</u>	<u>45</u>
<u>Blue clay</u>	<u>45</u>	<u>98</u>
<u>Coarse Sand</u>	<u>98</u>	<u>125</u>

WELL LOCATION:

sec. 8 T. 2 R. 11
S W
3 miles NE of Weggs
(distance) (direction) (nearest town)

WELL PURPOSE: HOME
(home, irrigation, municipal, industrial)

WELL COMPLETION DATA:

- (1) diameter (inches) 2"
- (2) total depth (feet) 115'
- (3) static water level (feet) 29' below top of ground.
- (4) casing Plastic 110'
(material) (depth)
- _____ if telescope see back.
(size)
- (5) screen 5' 110'
(length) (depth to top)
- 2" Plastic
(size) (material)
- (6) pump 1 10
(HP) (yield gpm)
- Elect
(type power)
- (7) electric log no
(yes or no)

CODED

_____ (organization running log)

(8) how well bottom plugged

Plugged

DRILLERS REMARKS:


RECEIVED

JUL 5 1974

MISS. BD. OF WATER COMM.

If well telescopes please sketch and show depths.

GROUND LEVEL

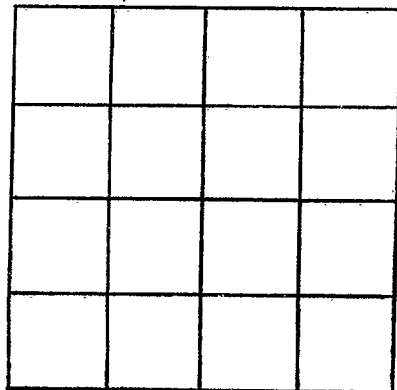

SECTION _____

Please indicate well location X.

ADDITIONAL INFORMATION

If more than one screen, show locations of each on sketch.