

STONE
C73
6-14-74

MISSISSIPPI
BOARD OF WATER COMMISSIONERS
416 North State Street
Jackson, Mississippi 39201

CODED

WATER WELL DRILLERS LOG

6-14 1974 Dannell Anderson Stone
date well completed firm name county well located

LANDOWNER:
Dannell Anderson
Rt 2 W Legins
(mailing address)

WELL LOCATION:
sec. 29 T. 2 S. R. 11 W.
1 miles E of W leg
(distance) (direction) (nearest town)

WELL PURPOSE: HOME
(home, irrigation, municipal, industrial)

- WELL COMPLETION DATA:
- (1) diameter (inches) 2"
 - (2) total depth (feet) 105'
 - (3) static water level (feet) 40' below top of ground.
 - (4) casing Plastic 100'
(material) (depth)
 - _____ If telescope see back.
(size)
 - (5) screen 5', 100'
(length) (depth to top)
 - 2", Plastic
(size) (material)
 - (6) pump 1 40
(HP) (yield gpm)
 - Elect
(type power)
 - (7) electric log no
(yes or no)
 - _____ (organization running log)
 - (8) how well bottom plugged Plugged

description of formations encountered	from	to
Top Soil	0	5
Pink Clay	5	18
Red Clay	28	44
White Clay	44	80
Coarse Sand	80	105


CODED

RECEIVED
JUL 5 1974

DRILLERS REMARKS:

If well telescopes please sketch and show depths.

GROUND LEVEL

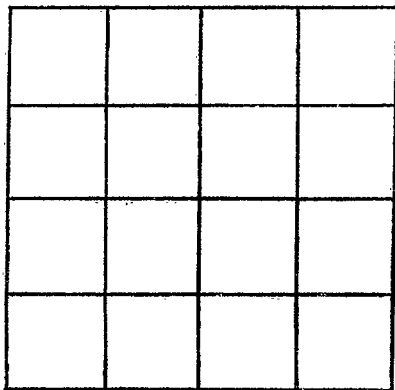

SECTION _____

Please indicate well location X.

ADDITIONAL INFORMATION

If more than one screen, show locations of each on sketch.