

STONE
C-74
6-17-74

MISSISSIPPI
BOARD OF WATER COMMISSIONERS
416 North State Street
Jackson, Mississippi 39201

CODED

WATER WELL DRILLERS LOG

6-17-74 date well completed
Dunnell Anderson Stone firm name
Stone county well located

LANDOWNER:

Richard Luce
Rt 1 Wiggins
(mailing address)

description of formations encountered

	from	to
Top Soil	0	3
white clay	3	45
B. blue clay	45	68
Coarse sand	68	85

WELL LOCATION:

sec. 26 T. 20 S. R. 11 E. W. 1
3 miles E of Wiggins
(distance) (direction) (nearest town)

WELL PURPOSE:

HOME
(home, irrigation, municipal, industrial)

WELL COMPLETION DATA:

- (1) diameter (inches) 4"
- (2) total depth (feet) 85'
- (3) static water level (feet) 35' below top of ground.
- (4) casing Plastic 80'
(material) (depth)
- (size) if telescope see back.
- (5) screen 5' 80'
(length) (depth to top)
- 2" Plastic
(size) (material)
- (6) pump 1/2 HP 10
(type power) (yield gpm)
- Elect
- (7) electric log no
(yes or no)
- (organization running log)
- (8) how well bottom plugged
Plugged

CODED


DECEMBER 1974

JUL - 5 1974

DRILLERS REMARKS:

If well telescopes please
sketch and show depths.

GROUND LEVEL

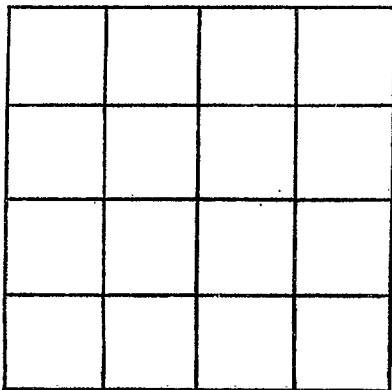

SECTION _____

Please indicate well location X.

ADDITIONAL INFORMATION

If more than one screen,
show locations of each on sketch.