

STONE  
C 75  
9/18/74

MISSISSIPPI  
BOARD OF WATER COMMISSIONERS  
416 North State Street  
Jackson, Mississippi 39201

WATER WELL DRILLERS LOG CODED

9-18 1974 Parnell Anderson Stone  
date well completed firm name county well located

LANDOWNER:

Lake-A-Way  
Rt 1 Wiggins  
(mailing address)

description of fomations encountered

from to

Top Soil 0 4

white sand 4 14

Clay 14 29

Coarse Sand 29 48

WELL LOCATION:

sec. 66 T. 2 S R. 11 W  
4 miles E of Wiggins  
(distance) (direction) (nearest town)

WELL PURPOSE: Municipal  
(home, irrigation, municipal, industrial)

WELL COMPLETION DATA:

(1) diameter (inches) 2"

(2) total depth (feet) 48

(3) static water level (feet) 15 below top of ground.

(4) casing Plastic 43'  
(material) (depth)

if telescope see back.  
(size)

(5) screen 5', 43'  
(length) (depth to top)

2", Plastic  
(size) (material)

(6) pump 1 12  
(HP) (yield gpm)

Electric  
(type power)

(7) electric log no  
(yes or no)

(organization running log)

(8) how bottom plugged  
Plugged

DRILLERS REMARKS:


CODED

RECEIVED

OCT 10 1974

If well telescopes please sketch and show depths.

GROUND LEVEL

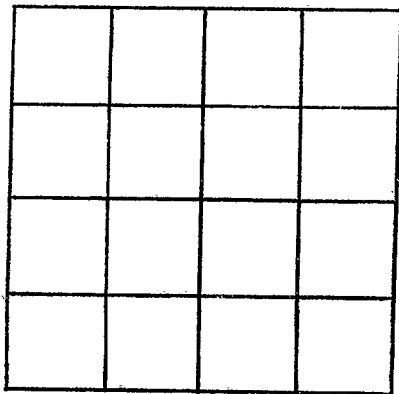

SECTION \_\_\_\_\_

Please indicate well location X.

ADDITIONAL INFORMATION

If more than one screen, show locations of each on sketch.