

STONE
C76
9/19/74

MISSISSIPPI
BOARD OF WATER COMMISSIONERS
416 North State Street
Jackson, Mississippi 39201

CODED

WATER WELL DRILLERS LOG

Parnell Anderson
firm name

Stone
county well located

9-19 19
date well completed

LANDOWNER:
Lake-A-way
RT 1 Bogaluis
(mailing address)

description of formations encountered	from	to
<u>Top Soil</u>	<u>8</u>	<u>3</u>
<u>Coarse sand</u>	<u>4</u>	<u>40</u>

WELL LOCATION:
sec 26 T 2 S R 4 W
3 miles E of Wlog
(distance) (direction) (nearest town)

WELL PURPOSE: Municipal
(home, irrigation, municipal, industrial)

CODED

WELL COMPLETION DATA:

(1) diameter (inches) 2"

(2) total depth (feet) 40'

(3) static water level (feet) 12 below top of ground.

(4) casing Plastic, 35'
(material) (depth)

 if telescope see back.
(size)

(5) screen 5', 35'
(length) (depth to top)

2", Plastic
(size) (material)

(6) pump 1, 10
(HP) (yield gpm)

Elect
(type power)

(7) electric log no
(yes or no)

(organization running log)

(8) how well bottom plugged
Plugged


REGISTERED

OCT 10 1974

DRILLERS REMARKS:

If well telescopes please sketch and show depths.

GROUND LEVEL

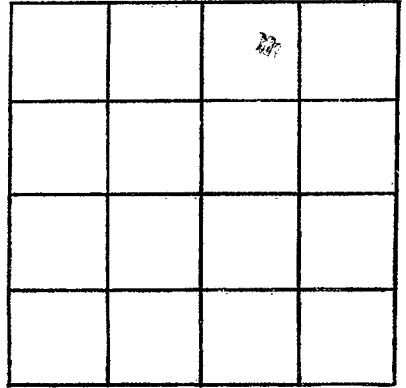

SECTION _____

Please indicate well location X.

ADDITIONAL INFORMATION

If more than one screen,
show locations of each on sketch.