

STONE  
 C77  
 10/24/74

MISSISSIPPI  
 BOARD OF WATER COMMISSIONERS  
 416 North State Street  
 Jackson, Mississippi 39201 CODED

WATER WELL DRILLERS LOG

10-24-74 date well completed      Parnell Anderson firm name      Stone county well located

LANDOWNER:  
 Pat Smith  
 (mailing address)

WELL LOCATION:  
 sec. 9 T. 2 N. R. 11 E. S. W.  
 5 miles NE of Wlog  
 (distance) (direction) (nearest town)

WELL PURPOSE: HOME  
 (home, irrigation, municipal, industrial)


- WELL COMPLETION DATA:
- (1) diameter (inches) 2"
  - (2) total depth (feet) 81'
  - (3) static water level (feet) 35' below top of ground.
  - (4) casing Plastic, 76' (material) (depth)
  - (size) if telescope see back.
  - (5) screen 5' length, 76' depth to top. 2" (size) Plastic (material)
  - (6) pump 1 (HP), 10 (yield gpm)  
 Elect (type power)
  - (7) electric log no (yes or no)
  - (organization running log)
  - (8) how well bottom plugged Plugged

description of formations encountered	from	to
Top Soil	0	4
Sandy clay	4	28
fine sand	28	65
coarse sand	65	81
CODED		
RECEIVED		
NOV 12 1974		

DRILLERS REMARKS:

If well telescopes please sketch and show depths.

GROUND LEVEL

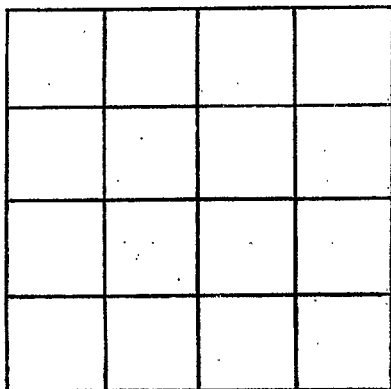

SECTION \_\_\_\_\_

Please indicate well location X.

ADDITIONAL INFORMATION

If more than one screen, show locations of each on sketch.