

STONE  
 C78  
 10/25/74

MISSISSIPPI  
 BOARD OF WATER COMMISSIONERS  
 416 North State Street  
 Jackson, Mississippi 39201

CODED

WATER WELL DRILLERS LOG

10-25 1974 Parnell Anderson Stone  
 date well completed firm name county well located

LANDOWNER:  
Red Naramore  
 (mailing address)

WELL LOCATION:  
 sec. 8 T. 2 S. R. 11 W.  
3 miles N.E. of Wlog  
 (distance) (direction) (nearest town)

WELL PURPOSE: HOME  
 (home, irrigation, municipal, industrial)

WELL COMPLETION DATA:

(1) diameter (inches) 2"  
 (2) total depth (feet) 130'  
 (3) static water level (feet) 47' below top of ground.  
 (4) casing Plastic, 117'  
 (material) (depth)  
 (size) if telescope see back.  
 (5) screen 5', 117'  
 (length) (depth to top)  
2", Plastic  
 (size) (material)  
 (6) pump 1 10  
 (HP) (yield gpm)  
Elect  
 (type power)  
 (7) electric log no  
 (yes or no)  
 (organization running log)  
 (8) how well bottom plugged Plugged

description of formations encountered	from	to
<u>Top Soil</u>	<u>0</u>	<u>3</u>
<u>white clay</u>	<u>3</u>	<u>30</u>
<u>Blue clay</u>	<u>30</u>	<u>38</u>
<u>lumpy clay</u>	<u>38</u>	<u>65</u>
<u>fine sand</u>	<u>65</u>	<u>90</u>
<u>coarse sand</u>	<u>90</u>	<u>130</u>


CODED

RECEIVED  
 NOV 12 1974

DRILLERS REMARKS:

If well telescopes please sketch and show depths.

GROUND LEVEL

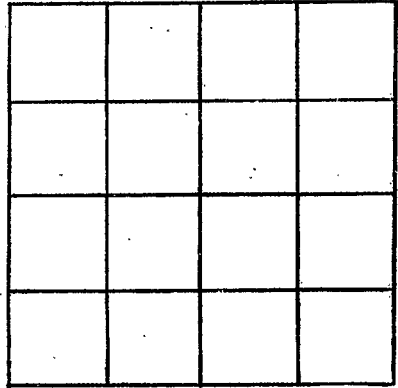

SECTION \_\_\_\_\_

Please indicate well location X.

ADDITIONAL INFORMATION

A series of horizontal lines for recording additional information.

If more than one screen, show locations of each on sketch.