

STONE
C79
10/7/74

MISSISSIPPI
BOARD OF WATER COMMISSIONERS
416 North State Street
Jackson, Mississippi 39201

CODED

WATER WELL DRILLERS LOG

10-7 1974 Parrell Anderson Stone
date well completed firm name county well located

LANDOWNER: Robert Deals
(mailing address)

description of formations encountered	from	to
<u>Top Soil</u>	<u>0</u>	<u>4</u>
<u>Red Clay</u>	<u>4</u>	<u>38</u>
<u>Hard Sand</u>	<u>38</u>	<u>45</u>
<u>Coarse Sand</u>	<u>45</u>	<u>83</u>

WELL LOCATION:
sec. 28 T 2 S R. 11 W
2 miles W of W. Leys
(distance) (direction) (nearest town)

WELL PURPOSE: HOME
(home, irrigation, municipal, industrial)

- WELL COMPLETION DATA:
- (1) diameter (inches) 2"
 - (2) total depth (feet) 83'
 - (3) static water level (feet) 35' below top of ground.
 - (4) casing Plastic, 78'
(material) (depth)
 - (size) if telescope see back.
 - (5) screen 5' 78'
(length) (depth to top)
 - 2" Plastic
(size) (material)
 - (6) pump 1 9
(HP) (yield gpm)
 - Elect
(type power)
 - (7) electric log no
(yes or no)
 - (organization running log)

(8) how well bottom plugged Back wash valve

DRILLERS REMARKS:


CODED

NOV 13 1974

MISS. BD. OF WATER COMMISSIONERS

If well telescopes please sketch and show depths.

GROUND LEVEL

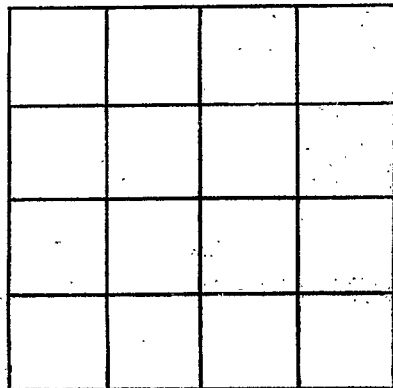

SECTION _____

Please indicate well location X.

ADDITIONAL INFORMATION

If more than one screen, show locations of each on sketch.