

STONE

C80

1-29-75

MISSISSIPPI BOARD OF WATER COMMISSIONERS
416 North State Street JACKSON, Mississippi 39201

WATER WELL DRILLERS LOG

1-29 date well completed

1975 Donnell Anderson firm name

Stone county well located

LANDOWNER:	description of formations encountered	from	to
<u>Ben Deaman</u>	<u>Top Soil</u>	<u>0</u>	<u>4</u>
(mailing address)	<u>Bed Clay</u>	<u>4</u>	<u>38</u>
WELL LOCATION:	<u>Fine Sand</u>	<u>38</u>	<u>35</u>
sec <u>34</u> T <u>2</u> N R <u>11</u> S W	<u>White Clay</u>	<u>35</u>	<u>100</u>
<u>4</u> miles <u>E</u> of <u>Wigg</u>	<u>Coarse Sand</u>	<u>100</u>	<u>125</u>
(distance) (direction) (nearest town)			
WELL PURPOSE: (home, irrigation, municipal, industrial)			
WELL COMPLETION DATA:			
(1) diameter (inches) <u>2"</u>			
(2) total depth (feet) <u>125'</u>			
(3) static water level (feet) <u>68'</u> below top of ground.			
(4) casing <u>Plastic</u> , <u>120'</u> (material) (depth)			
(size) If telescope see back.			
(5) screen <u>5'</u> , <u>120'</u> (length) (depth to top)			
<u>2"</u> , <u>Plastic</u> (size) (material)			
(6) pump <u>1</u> <u>8</u> (HP) (yield gpm)			
<u>Electric</u> (type power)			
(7) electric log <u>no</u> (yes or no)			
(organization running log)			
(8) how well bottom plugged <u>Plugged</u>			
DRILLERS REMARKS:			


CODED

MISSISSIPPI BOARD OF WATER COMMISSIONERS
FEB 3 1975

MISS. BU. OF WATER COMMISSIONERS

If well telescopes please sketch and show depths.

GROUND LEVEL

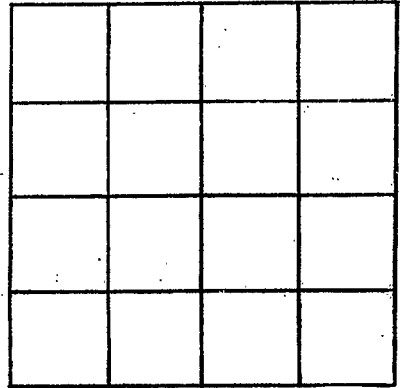

SECTION _____

Please indicate well location X.

ADDITIONAL INFORMATION

A series of horizontal lines for recording additional information, starting below the 'ADDITIONAL INFORMATION' header and extending to the bottom of the page.

If more than one screen, show locations of each on sketch.