

STONE
C81
2-25-75

MISSISSIPPI
 BOARD OF WATER COMMISSIONERS
 416 North State Street
 Jackson, Mississippi 39201

WATER WELL DRILLERS LOG **CODED**

2-25 1975 Donnell Anderson Stone
 date well completed firm name county well located

LANDOWNER:
Yed Rounsaville
 (mailing address)

WELL LOCATION:
 sec. 18 T. 2 N. R. 11 E. 13 S. W. 13
1 miles NE of Wiggins
 (distance) (direction) (nearest town)

WELL PURPOSE: HOME
 (home, irrigation, municipal, industrial)

- WELL COMPLETION DATA:
- (1) diameter (inches) 2"
 - (2) total depth (feet) 88
 - (3) static water level (feet) 57 below top of ground.
 - (4) casing Plastic, 83'
 (material) (depth)
 - (size) If telescope see back.
 - (5) screen 5', 83'
 (length) (depth to top)
2", Plastic
 (size) (material)
 - (6) pump 1 9
 (HP) (yield gpm)
Elect
 (type power)
 - (7) electric log no
 (yes or no)
 - (organization running log)
 - (8) how well bottom plugged Back with water

description of formations encountered	from	to
<u>Top Soil</u>	<u>0</u>	<u>4</u>
<u>Red clay</u>	<u>4</u>	<u>30</u>
<u>Sand</u>	<u>30</u>	<u>88</u>

CODED




MAR 13 1975

DRILLERS REMARKS:

If well telescopes please sketch and show depths.

GROUND LEVEL

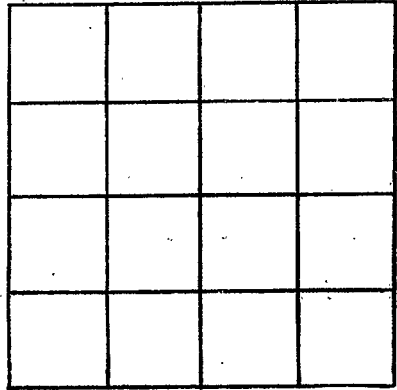

SECTION _____

Please indicate well location X.

ADDITIONAL INFORMATION

If more than one screen, show locations of each on sketch.