

**STONE**  
**C 82**  
**2-25-75**

MISSISSIPPI  
 BOARD OF WATER COMMISSIONERS  
 416 North State Street  
 Jackson, Mississippi 39201

CODED

WATER WELL DRILLERS LOG

2-25-75 1975 Parnell Anderson Stone  
 date well completed firm name county well located

LANDOWNER:	description of fomations encountered	from	to
A. H. Bond			
(mailing address)	white clay	4	18
WELL LOCATION:	fine sand	18	34
sec. 4 T 2 N R 11 E 13 Q	coarse sand	34	53
3 miles NE of Wigg			
(distance) (direction) (nearest town)			
WELL PURPOSE: HOME			
(home, irrigation, municipal, industrial)			
WELL COMPLETION DATA:			
(1) diameter (inches) 2"			
(2) total depth (feet) 5-3'			
(3) static water level (feet) 34 below top of ground			
(4) casing Plastic 48' (material) (depth)			
(size) If telescope see back.			
(5) screen 5' 48' (length) (depth to top)			
2" Plastic (size) (material)			
(6) pump 1 10 (HP) (yield gpm)			
E Vot (type power)			
(7) electric log no (yes or no)			
(organization running log)			
(8) how well bottom plugged Backward Valve			
DRILLERS REMARKS:			

CODED

MAR 13 1975


 
MISS. Bd. OF WATER

If well telescopes please sketch and show depths.

---

**GROUND LEVEL**

---

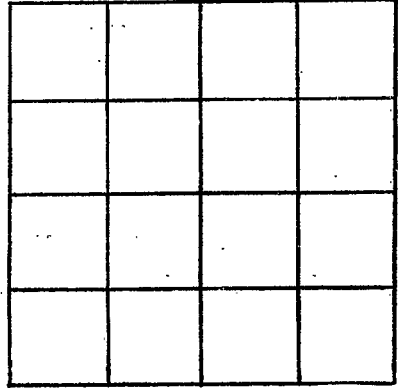

**SECTION** \_\_\_\_\_

Please indicate well location X.

**ADDITIONAL INFORMATION**

---

---

If more than one screen, show locations of each on sketch.

---