

C 83
 Stone
 5/21/75

MISSISSIPPI
 BOARD OF WATER COMMISSIONERS
 416 North State Street
 Jackson, Mississippi 39201

CODED

WATER WELL DRILLERS LOG

5-21 1975 Pernell Anderson Stone
 date well completed firm name county well located


LANDOWNER:	description of formations encountered	from	to
<u>Simon Gray</u>	<u>Top Soil</u>	<u>0</u>	<u>3'</u>
(mailing address)	<u>Red Clay</u>	<u>5'</u>	<u>18'</u>
WELL LOCATION:	<u>White Clay</u>	<u>18'</u>	<u>45'</u>
sec. <u>7</u> T. <u>2</u> S. R. <u>11</u> E.	<u>Fine Sand</u>	<u>45'</u>	<u>58'</u>
<u>1</u> miles <u>NE</u> of <u>Wiggins</u>	<u>Coarse Sand</u>	<u>58'</u>	<u>72'</u>
(distance) (direction) (nearest town)			
WELL PURPOSE: (home, irrigation, municipal, industrial)			
WELL COMPLETION DATA:			
(1) diameter (inches) <u>3"</u>			
(2) total depth (feet) <u>72'</u>			
(3) static water level (feet) <u>42'</u> below top of ground.			
(4) casing <u>Plastic 87'</u> (material) (depth)			
(size) If telescope see back.			
(5) screen <u>5'</u> <u>87'</u> (length) (depth to top)			
<u>2"</u> <u>Plastic</u> (size) (material)			
(6) pump <u>1</u> <u>9</u> (HP) (yield gpm)			
<u>Elect</u> (type power)			
(7) electric log <u>no</u> (yes or no)			
(organization running log)			
(8) how well bottom plugged <u>Backfilled with</u>			
DRILLERS REMARKS:			

RECORDED
 JUN 5 1975

MISS. BD. OF WATER COMM

If well telescopes please
sketch and show depths.

GROUND LEVEL

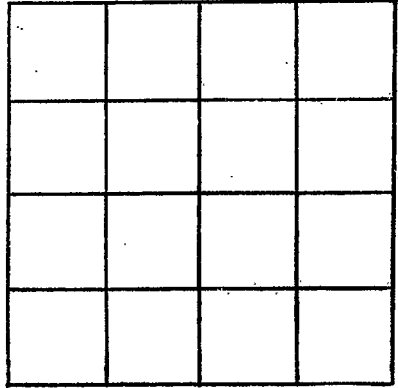

SECTION _____

Please indicate well location X.

ADDITIONAL INFORMATION

If more than one screen,
show locations of each on sketch.