

MISSISSIPPI
BOARD OF WATER COMMISSIONERS
 416 North State Street
 Jackson, Mississippi 39201

COL

C 84
Stone
5/24/75
C84

(355)

WATER WELL DRILLERS LOG

STONE

5-24 1975 Finch's Well Co Brookhaven
 date well completed firm name county well located

LANDOWNER: O.W.
Manfield
pt 1 Box 158 A
 (mailing address)

description of formations encountered	from	to
<u>20' sand clay</u>	<u>0</u>	<u>20</u>
<u>10' foot sand</u>	<u>30</u>	<u>40</u>

WELL LOCATION:
 sec 26 T 2 N R 4 E
5 miles SE of Wiggins
 (distance) (direction) (nearest town)

WELL PURPOSE:
 (home, irrigation, municipal, industrial)

- WELL COMPLETION DATA:
- diameter (inches) 2 1/2"
 - total depth (feet) 40 ft
 - static water level (feet) 18 below top of ground.
 - casing PVC 3.5" (material) (depth)
 - screen 5 ft 35" (length) (depth to top)
 - screen 10 5/16" (size) (material)
 - pump 1 6 (HP) (yield gpm)
 - (type power) 220
 - electric log NO (yes or no)
 - (organization running log)
 - how well bottom plugged wash valve


DRILLER'S RECEIVED
 MAY 29 1975

MISS. BD. OF WATER COMMISSIONERS

DRILLERS REMARKS:
good well

If well tele... please
sketch and show depths.

GROUND LEVEL

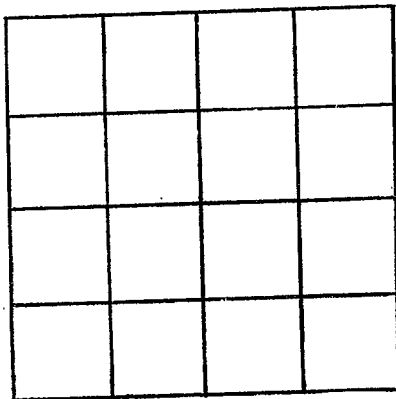

SECTION _____

Please indicate well location X.

ADDITIONAL INFORMATION

Lined area for additional information, consisting of approximately 18 horizontal lines.

If more than one screen,
show locations of each on sketch.