

Stone
C 85
6-17-75

MISSISSIPPI
BOARD OF WATER COMMISSIONERS
416 North State Street
Jackson, Mississippi 39201

CODED

WATER WELL DRILLERS LOG

6-17
date well completed

1975 *Carroll Anderson*
firm name

Stone
county well located

LANDOWNER:
Bert Fore

(mailing address)

WELL LOCATION:
sec. 5 T. 3 N. R. 11 E. 13 Q
3 miles NE of Wiggins
(distance) (direction) (nearest town)

WELL PURPOSE: HOME
(home, irrigation, municipal, industrial)

WELL COMPLETION DATA:
(1) diameter (inches) 2"
(2) total depth (feet) 275'
(3) static water level (feet) 78' below top of ground.
(4) casing Plastic 270'
(material) (depth)
(size) If telescope see back.
(5) screen 5' 270'
(length) (depth to top)
2" Plastic
(size) (material)
(6) pump 1 8
(HP) (yield gpm)
Elect
(type power)
(7) electric log no
(yes or no)

(organization running log)
(8) has well bottom plugged
Backward valve

description of formations encountered	from	to
<i>Top Soil</i>	<i>0</i>	<i>4</i>
<i>Red Clay</i>	<i>4</i>	<i>18</i>
<i>Fin Sand</i>	<i>18</i>	<i>54</i>
<i>white clay</i>	<i>54</i>	<i>90</i>
<i>Fin Sand</i>	<i>90</i>	<i>118</i>
<i>B. blue clay</i>	<i>118</i>	<i>230</i>
<i>Coarse Sand</i>	<i>230</i>	<i>275</i>


CODED

RECEIVED
JUL - 2 1975

DRILLERS REMARKS:

If well telescopes please sketch and show depths.

GROUND LEVEL

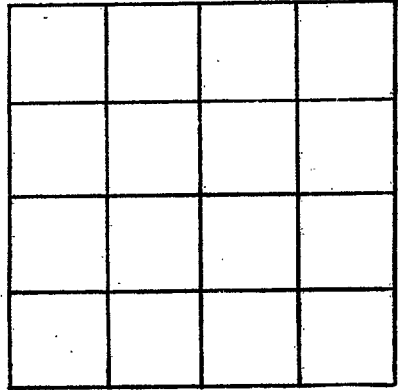

SECTION _____

Please indicate well location X.

ADDITIONAL INFORMATION

If more than one screen, show locations of each on sketch.