

Stone
C 86
6-4-75

MISSISSIPPI
BOARD OF WATER COMMISSIONERS
416 North State Street
Jackson, Mississippi 39201

WATER WELL DRILLERS LOG

CODED

6-4 1975 Small Business Stone
date well completed firm name county well located


LANDOWNER:	description of formations encountered	from	to
Anna L Smith	Top Soil	0	4
(mailing address)	Coarse Sand	4	42
WELL LOCATION:	White Clay	42	65
sec. 31 T. 2 N. R. 11 W. 139	Fine Sand	65	75
$\frac{1}{2}$ miles S of G. Logg.	Blue Clay	75	130
(distance) (direction) (nearest town)	Coarse Sand	130	170
WELL PURPOSE: 170 M.F.			
(home, irrigation, municipal, industrial)			
WELL COMPLETION DATA:			
(1) diameter (inches) 2"			
(2) total depth (feet) 170			
(3) static water level (feet) 160 below top of ground.			
(4) casing Plastic 160' (material) (depth)			
(size) If telescope see back.			
(5) screen 16' 160' (length) (depth to top)			
2" Plastic (size) (material)			
(6) pump 1 3.50 Per Hr (HP) (yield gpm)			
Elect (type power)			
(7) electric log No. (yes or no)			
(organization running log)			
(8) how well bottom plugged			
Backwash Valve			
DRILLERS REMARKS:			

CODED

RECEIVED
JUL - 9 1975

If well telescopes please
sketch and show depths.

GROUND LEVEL

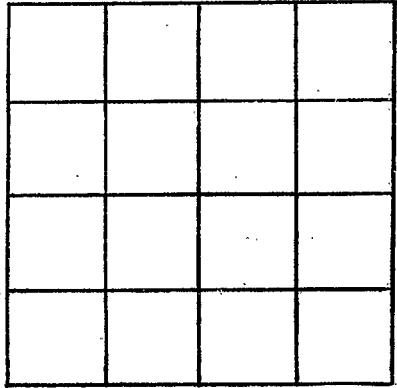

SECTION _____

Please indicate well location X.

ADDITIONAL INFORMATION

If more than one screen,
show locations of each on sketch.