

Stone
C 87
8-25-75

MISSISSIPPI
 BOARD OF WATER COMMISSIONERS
 416 North State Street
 Jackson, Mississippi 39201

WATER WELL DRILLERS LOG

CODED


8-25-75 1975 Parnell Anderson Stone
 date well completed firm name county well located

LANDOWNER:	description of formations encountered	from	to
<u>S. V. Jordan</u>	<u>Top Soil</u>	<u>0</u>	<u>4</u>
(mailing address)	<u>Red Clay</u>	<u>4</u>	<u>20</u>
WELL LOCATION:	<u>Sandy Cal</u>	<u>28</u>	<u>48</u>
sec. <u>29</u> T <u>2</u> N <u>13 Q</u> R <u>11</u> W <u>—</u>	<u>Coarse sand</u>	<u>28</u>	<u>103</u>
<u>1</u> miles <u>E</u> of <u>Wiggins</u> (distance) (direction) (nearest town)			
WELL PURPOSE: <u>HOME</u> (home, irrigation, municipal, industrial)			
WELL COMPLETION DATA:			
(1) diameter (inches) <u>2"</u>			
(2) total depth (feet) <u>129'</u>			
(3) static water level (feet) <u>55'</u> below top of ground.			
(4) casing <u>Plastic</u> , <u>117'</u> (material) (depth)			
(size) if telescope see back.			
(5) screen <u>5"</u> , <u>117'</u> (length) (depth to top)			
<u>2"</u> , <u>Plastic</u> (size) (material)			
(6) pump <u>1</u> , <u>11</u> (HP) (yield gpm)			
<u>Elect</u> (type power)			
(7) electric log <u>no</u> (yes or no)			
(organization running log)			
(8) how well bottom plugged <u>Back with Water</u>			
DRILLERS REMARKS:			

MISSISSIPPI
 BOARD OF WATER COMMISSIONERS
 SEP - 4 1975
 MISS. BD. OF WATER COMMISSIONERS

If well telescopes please
sketch and show depths.

GROUND LEVEL

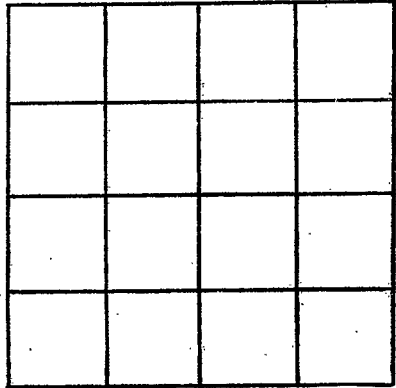

SECTION _____

Please indicate well location X.

ADDITIONAL INFORMATION

If more than one screen,
show locations of each on sketch.