

Stone
C 88
9-8-75

MISSISSIPPI
BOARD OF WATER COMMISSIONERS
416 North State Street
Jackson, Mississippi 39201

CODED

WATER WELL DRILLERS LOG

9-8
date well completed

1975 *Carroll Anderson*
firm name


Stone
county well located

| LANDOWNER: | description of formations encountered | from | to |
|--|---------------------------------------|------|-----|
| <i>Orvis K. Wickman</i> | <i>Top Soil</i> | 0 | 2' |
| (mailing address) | <i>white clay</i> | 2' | 24' |
| WELL LOCATION: | <i>Blue clay</i> | 24' | 75' |
| sec. <i>S 2</i> T. <i>2</i> R. <i>11</i> 139 | <i>Fine sand</i> | 75' | 81' |
| <i>4</i> miles <i>NE</i> of <i>W. Lynn</i> | | | |
| (distance) (direction) (nearest town) | | | |
| WELL PURPOSE: <i>HOME</i> | | | |
| (home, irrigation, municipal, industrial) | | | |
| WELL COMPLETION DATA: | | | |
| (1) diameter (inches) <i>2"</i> | | | |
| (2) total depth (feet) <i>81'</i> | | | |
| (3) static water level (feet) <i>18'</i> below top of ground | | | |
| (4) casing <i>Plastic 76'</i> (material) (depth) | | | |
| (size) if telescope see back. | | | |
| (5) screen <i>5' 76'</i> (length) (depth to top) | | | |
| <i>2" Plastic</i> (size) (material) | | | |
| (6) pump <i>1 9</i> (HP) (yield gpm) | | | |
| <i>Electric</i> (type power) | | | |
| (7) electric log <i>no</i> (yes or no) | | | |
| (organization running log) | | | |
| (8) how well bottom plugged <i>plugged</i> | | | |
| DRILLERS REMARKS: | | | |

MISSISSIPPI BOARD OF WATER COMMISSIONERS
JUN 6 1975
MISSISSIPPI BOARD OF WATER COMMISSIONERS

If well telescopes please sketch and show depths.

GROUND LEVEL

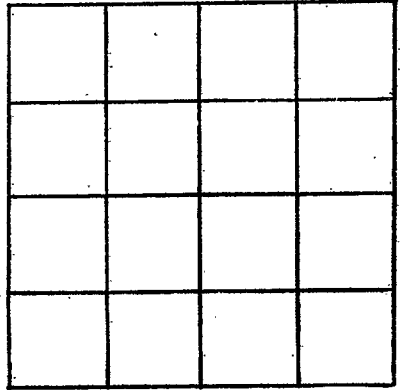

SECTION _____

Please indicate well location X.

ADDITIONAL INFORMATION

If more than one screen, show locations of each on sketch.