

Stone  
C 89  
9-3-75

MISSISSIPPI  
BOARD OF WATER COMMISSIONERS  
416 North State Street  
Jackson, Mississippi 39201

CODED

WATER WELL DRILLERS LOG

9-3 19 *Arnold Anderson* Stone  
date well completed firm name county well located


LANDOWNER:	description of formations encountered	from	to
<i>Fred Doe</i>	<i>Top Soil</i>	<i>0</i>	<i>4</i>
(mailing address)	<i>Red Clay</i>	<i>4</i>	<i>18</i>
WELL LOCATION:	<i>Final Sand</i>	<i>18</i>	<i>90</i>
sec. <i>5</i> T. <i>2</i> N. R. <i>11</i> E. <i>13</i> Q	<i>Coarse Sand</i>	<i>70</i>	<i>90</i>
<i>4</i> miles <i>NE</i> of <i>W. Eggle</i>			
(distance) (direction) (nearest town)			
WELL PURPOSE: <i>HOME</i>			
(home, irrigation, municipal, industrial)			
WELL COMPLETION DATA:			
(1) diameter (inches) <i>4"</i>			
(2) total depth (feet) <i>90'</i>			
(3) static water level (feet) <i>16'</i> below top of ground.			
(4) casing <i>Plastic</i> , <i>80'</i>			
(material) (depth)			
(size) If telescope see back.			
(5) screen <i>10'</i> , <i>80'</i>			
(length) (depth to top)			
(size) <i>Plastic</i>			
(material)			
(6) pump <i>1/2</i> , <i>12</i>			
(HP) (yield gpm)			
<i>Elect</i>			
(type power)			
(7) electric log <i>no</i>			
(yes or no)			
(organization running log)			
(8) how well bottom plugged <i>Back with U-dug</i>			
DRILLERS REMARKS:			

OCT - 6 1975

MISS. BOARD OF WATER COMMISSIONERS

If well telescopes please sketch and show depths.

GROUND LEVEL

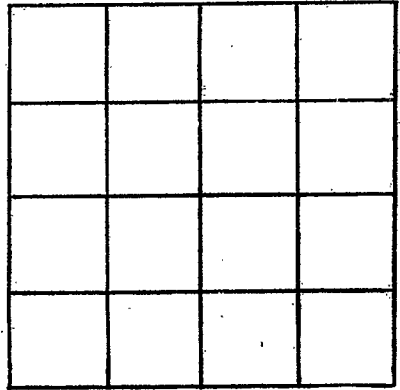

SECTION \_\_\_\_\_

Please indicate well location X.

ADDITIONAL INFORMATION

If more than one screen, show locations of each on sketch.