

STONE
C90
8-19-77
F-log # 54

MISSISSIPPI
BOARD OF WATER COMMISSIONERS
416 North State Street
Jackson, Mississippi 39201

WATER WELL DRILLERS LOG **CODED**

Aug 19 1977 Bryant Well Co Stone
date well completed firm name county well located

LANDOWNER: Dr. W.W. Cox
Big Level Community
Wiggins Ms.
(mailing address)

WELL LOCATION:
sec. 36 T 2 N R 11 E
7 miles E of Wiggins
(distance) (direction) (nearest town)

WELL PURPOSE: home
(home, irrigation, municipal, industrial)

- WELL COMPLETION DATA:
- (1) diameter (inches) 4" x 2"
 - (2) total depth (feet) 791
 - (3) static water level (feet) 132 ^{below} above top of ground.
 - (4) casing Galv. 771
(material) (depth)
4" x 2" if telescope see back.
(size) 20'
 - (5) screen 20' 791
(length) (depth to top)
1/2" 50 mesh
(size) (material)
 - (6) pump 1 1/2 20
(HP) (yield gpm)
Blct
(type power)
 - (7) electric log yes
(yes or no)
MGS
(organization running log)
 - (8) how well bottom plugged Metal
sand shank

description of formations encountered	from	to
Red clay	0	25
sand	25	35
clay	35	80
sand	80	160
Blue clay	160	373
fine sand	373	390
Blue clay	390	512
fine sand	512	520
Blue clay	520	641
sand	641	677
Blue clay	677	703
fine sand	703	714
Blue clay	714	791
fine sand	791	791

CODED

RECEIVED



SEP 27 1977

MISS. BOARD OF WATER COMMISSIONERS

DRILLERS REMARKS:

If well telescopes please sketch and show depths.

GROUND LEVEL

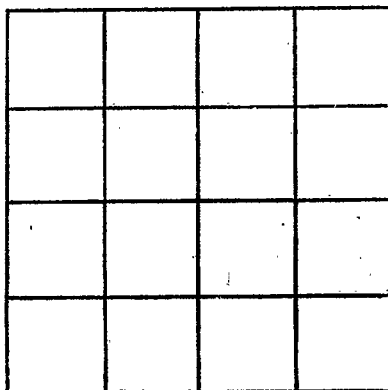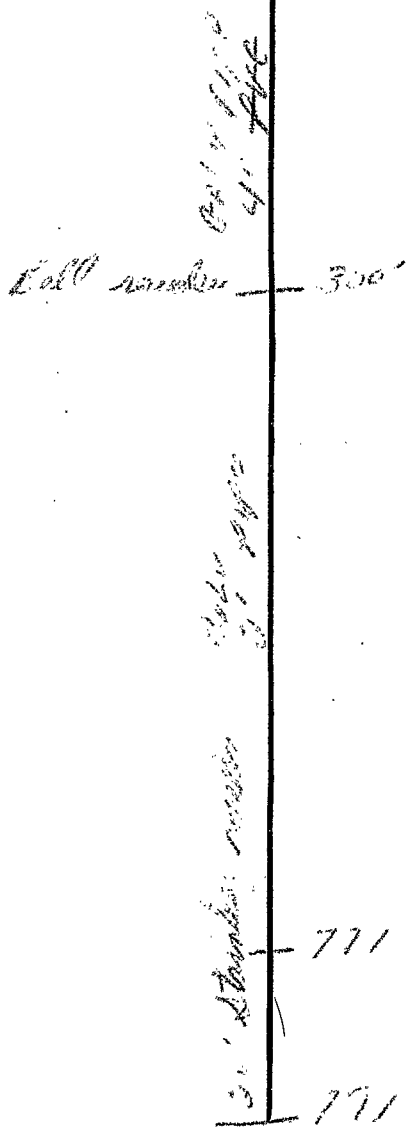

SECTION 20

Please indicate well location X.

ADDITIONAL INFORMATION

If more than one screen, show locations of each on sketch.