

CODED

STONE
C91
9/27/78

MISSISSIPPI
BOARD OF WATER COMMISSIONERS
416 North State Street
Jackson, Mississippi 39201

WATER WELL DRILLERS LOG

9-27

date well completed

1978 *Parnell Anderson Stone*

firm name

county well located

LANDOWNER:

H C Ladner

description of formations encountered


from to

| | | |
|--------------------|-----------|------------|
| <i>Top Soil</i> | <i>0</i> | <i>2</i> |
| <i>Fine Sand</i> | <i>2</i> | <i>72</i> |
| <i>Coarse Sand</i> | <i>72</i> | <i>105</i> |

(mailing address)

WELL LOCATION:

sec *32 T 2*

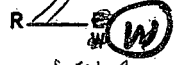

1 miles *E* of *Wloggin*
(distance) (direction) (nearest town)

WELL PURPOSE: *HOME*
(home, irrigation, municipal, industrial)

WELL COMPLETION DATA:

- (1) diameter (inches) *4"*
- (2) total depth (feet) *105'*
- (3) static water level (feet) *28* below top of ground.
- (4) casing *Plastic*, *95'*
(material) (depth)
- (size) if telescope see back.
- (5) screen *10*, *95'*
(length) (depth to top)
- 4"*, *Plastic*
(size) (material)
- (6) pump *1*, *30*
(HP) (yield gpm)
- Elect*
(type power)
- (7) electric log *no*
(yes or no)
- (organization running log)
- (8) how well bottom plugged
Capped


DRILLERS REMARKS:

RECEIVED
OCT 12 1978

MISS. BD. OF WATER COMMISSIONERS

If well telescopes please sketch and show depths.

GROUND LEVEL

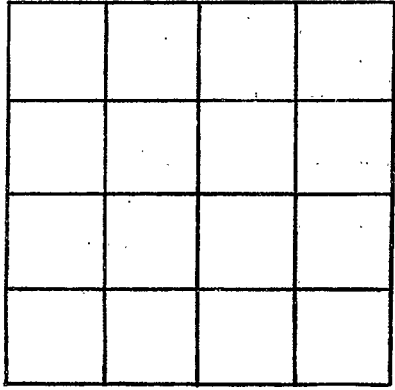

SECTION _____

Please indicate well location X.

ADDITIONAL INFORMATION

If more than one screen, show locations of each on sketch.