

STONE
C 93
3/18/80

MISSISSIPPI
BOARD OF WATER COMMISSIONERS CODED
416 North State Street
Jackson, Mississippi 39201

WATER WELL DRILLERS LOG well #2

3-18 1980 Bladen Pump and Stone
date well completed firm name county well located
Well Serv. Inc.

LANDOWNER: Dunn Paper Co
Do. Box 97
Wiggins, MS 39577
(mailing address)

description of formations encountered	from	to
Clay	0	50
Sand	50	70
Clay	70	280
Sand	280	360
Clay	360	480
Sand	480	560

SW WELL LOCATION:
sec. 30 T. 2 S. R. 11 E
miles in of Wiggins
(distance) (direction) (nearest town)

WELL PURPOSE:
(home, irrigation, municipal, industrial)

WELL COMPLETION DATA:

- (1) diameter (inches) 8"
- (2) total depth (feet) 560'
- (3) static water level (feet) 110' below top of ground.
- (4) casing steel, total (material), (depth)
8" if telescope see back. (size)
- (5) screen 60', 500' (length), (depth to top)
6", SS uncoated (size), (material)
- (6) pump 50 turbine 700 (HP), (yield gpm)
2486 (type power)
- (7) electric log no (yes or no)
(organization running log)
- (8) how well bottom plugged
6" bit valve

CODED

DEPT. OF NATURAL RESOURCES
BUREAU OF LAND & WATER RESOURCES

JUN 25 1980


RECEIVED

DRILLERS REMARKS:
No tail pipe

(K)

If well telescopes please sketch and show depths.

GROUND LEVEL

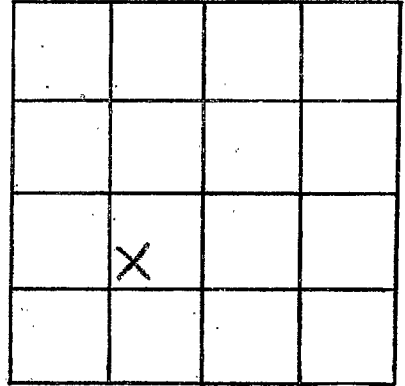

SECTION 30

Please indicate well location X.

ADDITIONAL INFORMATION

If more than one screen,
show locations of each on sketch.