

STONE
C 94
10-16-80

MISSISSIPPI
BOARD OF WATER COMMISSIONERS
416 North State Street
Jackson, Mississippi 39201

CODED

WATER WELL DRILLERS LOG

10-16-1980 date well completed Layne Central Company firm name Stone county well located

LANDOWNER:
Town of Wiggins
Wiggins, Miss.
(mailing address)

WELL LOCATION:
sec. 30 T 2 S R. 11 W
19
miles (distance) of (direction) (nearest town)

WELL PURPOSE: Municipal
(home, irrigation, municipal, industrial)

WELL COMPLETION DATA:

(1) diameter (inches) 16"

(2) total depth (feet) 948'

(3) static water level (feet) 165' below top of ground.

(4) casing Steel, 845'
(material) (depth)

16" if telescope see back.
(size) 65' 10"

(5) screen 90', 845'
(length) (depth to top)

10", Stainless Steel
(size) (material)

(6) pump 150 1,000
(HP) (yield gpm)

Electric
(type power)

(7) electric log Yes
(yes or no)
Layne Central Company
(organization running log)

(8) how well bottom plugged Valve

description of formations encountered	from	to
Red Clay	0	15'
Sand & Gravel	15'	105'
Sand, Coarse Pea Gravel	105'	197'
Hard Blue Clay	197'	270'
Sand, Shale + Hard Strata	270'	365'
Hard Clay	365'	428'
Sandy Shale	428'	460'
Hard Clay + Soft Strata	460'	585'
Sandy Shale + Hard Strata	585'	660'
Sand + Shale	660'	695'
Hard Shale	695'	770'
Sandy Shale	770'	820'
Sand Hard Shale Strata	820'	843'
Sand Coarse	843'	946'
Hard, Runny Shale	946'	1,000'

5
2
15
2
1
13

CODED

DEPT. OF NATURAL RESOURCES
BUREAU OF LAND & WATER RESOURCES

NOV - 7 1980


RECEIVED

DRILLERS REMARKS:

(K)

If well telescopes please sketch and show depths.

GROUND LEVEL

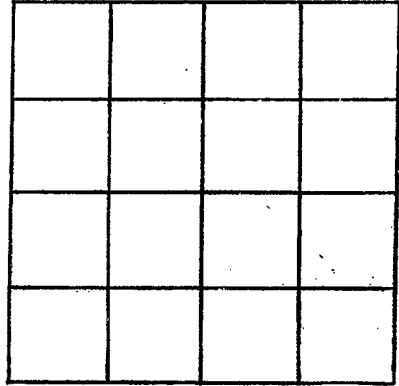

SECTION _____

Please indicate well location X.

ADDITIONAL INFORMATION

A series of horizontal lines for recording additional information, starting below the 'ADDITIONAL INFORMATION' header and extending down to the bottom of the page.

If more than one screen, show locations of each on sketch.