

MISSISSIPPI DEPARTMENT OF NATURAL RESOURCES

Bureau of Land and Water Resources

Southport Mall

P.O. Box 10631 **CODED**

Jackson, Mississippi 39209

WATER WELL DRILLERS LOG

Stone
C. 95
9/29/82

9-29-82 date well completed Frank Price firm name Stone county well located

LANDOWNER:
Claud Lott

(mailing address)

description of formations encountered	from	to
Top Soil	0	3
Red clay	3	18
Hard Sand	18	105
Coarse Sand	105	125

WELL LOCATION:
sec. 13 T. 2 R. 11
1 1/2 miles N of Whites Cross
(distance) (direction) (nearest town)

WELL PURPOSE: HOME
(home, irrigation, municipal, industrial)

WELL COMPLETION DATA:

(1) diameter (inches) 4"

(2) total depth (feet) 125'

(3) static water level (feet) 60' below top of ground.

(4) casing Plastic, 115'
(material) (depth)

_____ if telescope see back.
(size)

(5) screen 10', 115'
(length) (depth to top)
4", Plastic
(size) (material)

(6) pump 1 1/2, 60
(HP) (yield gpm)
Elect
(type power)

(7) electric log no
(yes or no)

_____ (organization running log)

CODED

DEPT. OF NATURAL RESOURCES
BUREAU OF LAND & WATER RESOURCES

OCT - 5 1982


RECEIVED

(8) how well bottom plugged
Backwash valve

DRILLERS REMARKS:

If well telescopes please sketch and show depths.

GROUND LEVEL

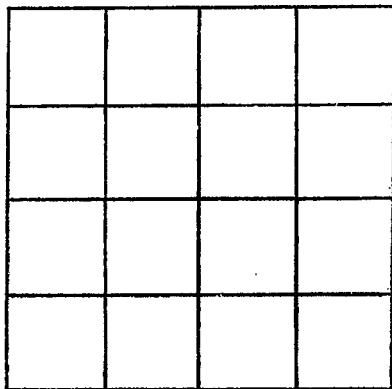

SECTION _____

Please indicate well location X.

ADDITIONAL INFORMATION

If more than one screen, show locations of each on sketch.