

State Well Report

Part I

Mississippi Department of Environmental Quality
Office of Land and Water Resources
P.O. Box 10631
Jackson, MS 39289-0631
(601)961-5210
(601)354-6938 (fax)

For Office Use Only:

Aquifer: _____
Well #: C-138
L. S. Elevation: _____
E-log #: _____

County: Stone
Permit #: _____
Driller: Mattew's Drilling Inc.
Date drilling completed: 8/18/04

State Law requires that this report be prepared by the driller in detail and filed with the Department within 30 days of completion of drilling of the well.

Well Owner Information	Well Location
Owner Name: <u>Don Kadlubowski</u>	Latitude: _____ Longitude: _____
Mailing Address: <u>160 Gavin Rd.</u>	Method of Lat/Long (circle one): <input type="checkbox"/> Conventional Survey, <input type="checkbox"/> USGS quad, <input type="checkbox"/> Hand-held GPS, <input type="checkbox"/> Survey-grade GPS
<u>Wiggins</u> MS <u>39577</u>	<u>SE</u> 1/4 <u>SE</u> 1/4 Sec <u>22</u> Twn <u>2S</u> Rng <u>11W</u>
City State Zip Code	Distance Direction Nearest Town
Telephone No. (<u>601</u>) <u>466-3793</u>	<u>3</u> Miles <u>West</u> of <u>Wiggins</u>

Well Data

Purpose of Well (circle one) Home Industrial Public Supply Irrigation Fish Culture Other: _____

Date well drilling started: 8/17/04 Date well drilling completed: 8/18/04

If flowing, method of flow regulation: Valve _____ Other (describe) _____

Static Water Level: 20' feet above or below (circle one) land surface Date measured: 8/18/04

Method of Measurement (circle one) steel tape electric tape air line other: _____

Hole depth: 90' Well depth: 90' Well grouted to a depth of 10' feet

Type of grout (circle one): Cement Bentonite Mix

Casing length: 80' feet Casing diameter: 2" inches Type of casing: PVC 40

Screen length: 10' feet Screen diameter: 2" inches Type of screen: PVC 40

Screen slot size: # 12 inches Setting depth: From 80' feet to 90' feet

Type of completion (circle all applicable) Gravel packed Underreamed Telescoped Open hole Natural Development

Other (describe): _____

Top of lap pipe or reduction in casing: _____ feet. If telescoped or more than one screen, describe on back of page


Logs run (circle all applicable) No log run Electric Gamma Ray Density Sonic Neutron Other: _____

Name of organization running log(s): _____

RECEIVED
SEP 01 2004
BY: OLWR

I certify that the well was drilled, constructed, and completed in accordance with all applicable requirements of the Mississippi Department of Environmental Quality and/or the Mississippi Department of Health regulations and state laws.

John M. Mattew's #690

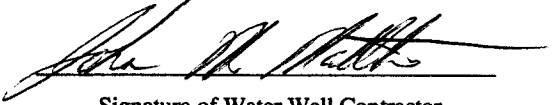

Print Name of Water Well Contractor and License No.

Signature of Water Well Contractor

STATE WELL REPORT

Part 2

Pump Installer's Completion Report
 Mississippi Department of Environmental Quality
 Office of Land and Water Resources
 P.O. Box 10631
 Jackson, MS 39289-0631
 (601)961-5210
 (601)354-6938 (fax)

For Office Use Only:

Aquifer: _____

Well #: C-138

Elevation: _____

County: Stone
 Permit #: _____
 Driller: Matthews Drilling, Inc.
 Date completed: 8/18/04

This report should be prepared by the pump installer in detail and filed with the Department within 30 days of the installation of pump.

Well Owner Information	Well Location
Owner Name: <u>Don Kadlubowski</u>	Latitude: _____ Longitude: _____
Mailing Address: <u>160 Gurin Rd</u>	Method of Lat/Long (circle one): Conventional Survey,
<u>Wiggins MS 39577</u>	USGS quad, Hand-held GPS, Survey-grade GPS
City State Zip Code	<u>SE 1/4 SE 1/4 Sec 22 Twn 2S Rng 11W</u>
Telephone No. <u>(601) 466-3793</u>	Distance Direction Nearest Town
	<u>3 Miles West of Wiggins</u>

Pump Type Circle one	Power Type Circle one
Air Lift <input type="radio"/> Jet <input checked="" type="radio"/> Submersible	Diesel Engine Gasoline Engine Natural Gas
Bucket <input type="radio"/> Piston <input type="radio"/> Turbine	<input checked="" type="radio"/> Electric Motor <input type="radio"/> Hand <input type="radio"/> Tractor PTO
Centrifugal <input type="radio"/> Rotary <input type="radio"/> Flowing Well	Windmill Other (specify): _____
Other (specify): _____	Horse Power Rating of Motor: <u>1 hrs</u>
Date Pump Installed: <u>8/18/04</u>	Setting Depth: <u>60' Foot Valve feet</u>
Rated Pump Capacity: <u>8</u> Gallons Per Minute	Number of Stages: <u>1</u>

RECEIVED
 SEP 01 2004
 BY: OLWR

Pump Test Data	Method of Measuring Water Level Circle one
Date Well Tested: <u>8/18/04</u>	Air Line Electric Measuring Line <input checked="" type="radio"/> Steel Tape
Static Water Level (A): <u>20'</u> Feet Below Land Surface	Other (specify): _____
Pumping Water Level (B): <u>30'</u> Feet Below Land Surface	For flowing well, measured shut in head: _____ feet
Drawdown [(B) - (A)]: <u>10'</u> Feet Below Land Surface	Well yielded <u>8</u> GPM with a drawdown of
Test Pumping Rate: <u>8</u> Gallons Per Minute	<u>10</u> feet after <u>4</u> hours of pumping
Duration of Pump Test (minimum 4 hours): <u>4</u> hours	

I HEREBY CERTIFY that the above statements are true to the best of my knowledge.

John M. Matthews #690 John M. Matthews
 Print Name of Pump Installer and License No. (if applicable) Signature of Pump Installer