
State Well Report					
County Stane	art 1 For Office Use Only:				
Mississippi Departmen	t of Environmental Quality Aquifer:				
Permit #: Office of Land a	nd Water Resources Well #: 0-14 131				
Driller: Moores Water Well Service Jackson, M	S 39289-0631				
Date drilling completed: 9-3-2004 (601)	961-5210 L. S. Elevation:				
(601)354	4-6938 (fax) E-log #:				
State I are persient that this persent has seen at the					
State Law requires that this report be prepared by the 30 days of completion of drilling of the well.	driller in detail and filed with the Department within				
Well Owner Information	Well Location				
Owner Name Wayne Fergeson	Latitude:°" Longitude:°"				
Mailing Address: Wayne Fargeson	Method of Lat/Long (circle one): Conventional Survey,				
18 Friends hip lane	USGS quad, Hand-held GPS, Survey-grade GPS				
Wiggins MS 39572 City State Zip Code	1414 Sec_ 27 Twn_ 25 Rng 11 W				
•	Distance Direction Nearest Town				
Telephone No. ()	Distance Direction Nearest Town Miles 595 of Wiggins				
Well D					
Purpose of Well (circle one Home Industrial Public Supply					
Date well drilling started: 9-2-2004 Date w	vell drilling completed: 9-3-2004				
If flowing, method of flow regulation: Valve Other (de	escribe)				
Static Water Level: 39 feet above or below (circle one) la	and surface Date measured: 9-3-2004				
Method of Measurement (circle one) steel tape electric tape air line other:					
Hole depth: 8D Well depth: 8D Well grouted to a depth of 1D feet SEP 2 3 2					
Type of grout (circle one): Cement Bentonite Mix					
Casing length: 75 feet Casing diameter: 2 inches Type of casing: PUCSCH PO					
Screen length: 5 feet Screen diameter: 2 inches Type of screen: PVC					
Screen slot size:, D8inches Setting depth: From					
Type of completion (circle all applicable): Gravel packed Underreamed Telescoped Open hole Natural Development					
Other (describe):					
Top of lap pipe or reduction in casing:feet. If tele	escoped or more than one screen, describe on back of page				
Logs run (circle all applicable). No log run Electric Gamma Ray Density Sonic Neutron Other: Self-run					
Name of organization running log(s):					
I certify that the well was drilled, constructed, and completed in accordance with all applicable requirements of the Mississippi					
Department of Environmental Quality and/or the Mississippi Department of Health regulations and state laws.					
Arnold Ray Moore 0-05-33 arnold Hay more					
Print Name of Water Well Contractor and License No.	Signature of Water Well Contractor				

	Ground Le	evel		
ECE	EIVED)		
SEP 2	3 2004			

Description of Formations Encountered	From	To
toosoil	11	2'
redictar	12/	221
white soapstone coarse whitesand	122	£5.
coarse whitesand	70	NO.
	1	
		
		
		
		<u> </u>
		ļ
		ļ
		
		
		1
		J

BY: O LIMPRan one screen, show location of each on sketch

REC

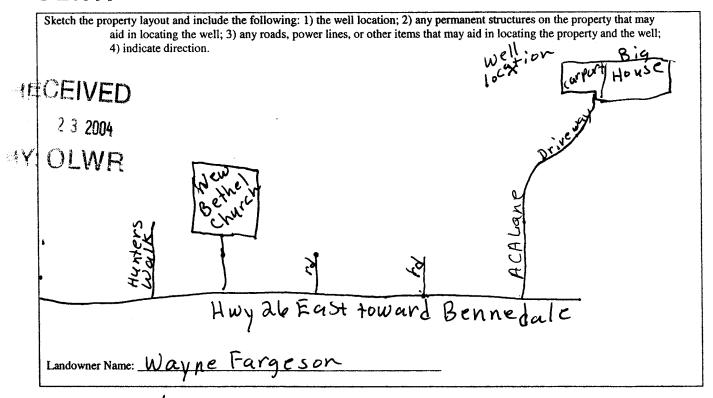

Signature of Water Well Contractor

STATE WELL REPORT

Part 2 County: Stone Permit #:

Pump Installer's Completion Report
Mississippi Department of Environmental Quality
Office of Land and Water Resources

Driller: Mpores Water well Service P.O. Box 10631
Jackson, MS 39289-0631

For Office Use Only: Aquifer:

Date completed: 7-3-2004		1)961-5210 354-6938 (fax) Elevation:					
This report should be prepared by the installation of pump.	pump installer in deta	ail and filed with th	e Department				_
Well Owner Information	on			Location			-
Owner Name: Wayne Farg	eson	Latituda					
Mailing Address: Wayne Far	1 0 5 DL	Latitude:					
18 En's	y csox	Method of Lat/Lo	ong (circle one)	: Conventio	nal Survey,		
18 Friend			quad, Hand-h				
Wiggins MS City State	39577 Zip Code	14		7 Twn 2.	<u>S</u> _{Rng_/}	1W	
The state of the s			Direction	Nearest T			
Telephone No. ()_		Miles	East of	Wigg	i'ns		
Pump Type		<u> </u>	Power	г Туре			_/ ¬
Circle one				e one			
Air Lift (Jet)	Submersible	Diesel Engine	Gasoline I	Engine	Natural	l Gas	
Bucket Piston	Turbine	Electric Motor	Hand		Tractor	РТО	
Centrifugal Rotary	Flowing Well	Windmill	Other (spe	cify):			
Other (specify):		Horse Power Ratin				CEI	VE
Date Pump Installed: 9-3-20	04	Setting Depth:				to bear from I	1
Rated Pump Capacity:G	,	Source Depair.	7		_feet 5	zr 23	2004
	anons i el iviniute	Number of Stages:		·	- BY	OL	W
Pump Test Data			thod of Measu				
Date Well Tested:			Circle	one	Level		
Static Water Level (A):Feet Be	1		lectric Measuri		Steel Tap)e	
Pumping Water Level (B):Feet Bel	ow Land Surface	Other (specify):			· · · · · · · · · · · · · · · · · · ·		
Drawdown [(B) - (A)]:Feet Bei	low Land Surface	For flowing well, n	neasured shut in	n head:	(feet	
Test Pumping Rate:Ga	llons Per Minute	Well yielded				- 1	
Duration of Pump Test (minimum 4 hours):	hours		feet after			i	
I HEREBY CERTIFY that the above statements Print Name of Pump Inchiles and Vision 1988		my knowledge.	Day 1	ango	 7e		

ame of Pump Installer and License No. (if applicable) Signature of Pump Installer