

County: Stone
 Permit #: _____
 Driller: _____
 Date drilling completed: _____

State Well Report Part 1 - Driller's Log

Mississippi Department of Environmental Quality
 Office of Land and Water Resources
 P.O. Box 10631
 Jackson, MS 39289-0631
 (601)961-5210
 (601)354-6938 (fax)

For Office Use Only:

Aquifer: _____
 Well #: C 176
 L. S. Elevation: _____
 E-log #: _____

State Law requires that this report be prepared by the license holder responsible for the work and filed with the Department at the above address within 30 days of completion of drilling of the well or borehole.

Information on Well Owner <small>(Landowner if borehole is not for a water well)</small>	Well or Borehole Location
Owner Name: <u>Greg Bowden</u>	Latitude: <u>30° 51' 17"</u> Longitude: <u>89° 4' 48"</u>
Mailing Address: <u>Big Four Road</u>	Method of Lat/Long (circle one): Conventional Survey, <u>Hand-held GPS</u> , Survey-grade GPS
<u>Wiggins MS 39577</u> City State Zip Code	USGS quad, <u>SE 1/4 SW 1/4 Sec 22 Twn 2 S Rng 11 W</u>
Telephone No. <u>(251) 751-5961</u>	Distance Direction Nearest Town <u>4.5 Miles East of Wiggins</u>

Well / Borehole Data

Date drilling started: 10-14-13 Date drilling completed: 10-18-13 Hole depth: 77' Hole diameter: 6.5"

Location of the source of any surface water used for drilling: _____
 Method of dosing and volume of Chlorine used in drilling and development: _____

Logs run (circle all applicable): No log run Electric Gamma Ray Density Sonic Neutron Other: _____
 Name of organization running log(s): _____

Purpose of borehole (check one): Water Well Geotechnical/Geological Investigation _____ Ground Source Heat Pump _____
 Seismic Survey _____ Other (describe) _____

If drilling is not related to water well construction, skip the remainder of this block

Purpose of Well (check one): Home Industrial _____ Public Supply _____ Irrigation _____ Fish Culture _____ Other: _____

If a flowing well, method of flow regulation: Valve _____ Other (describe) _____

Static Water Level: 20.5 feet above or below (circle one) land surface Date measured: 10-17-13

Method of Measurement (circle one) steel tape electric tape air line other: _____

Well depth: 78' Well grouted to a depth of 10 feet Type of grout (circle one): Neat Cement Bentonite Mix

Casing length: 58' feet Casing diameter: 4 inches Type of casing: PVC

Screen length: 20 feet Screen diameter: 4 inches Type of screen: PVC

Screen slot size: 0.008 inches Setting depth: From 58' feet to 78' feet

Type of completion (circle all applicable): Gravel packed Underreamed Telescoped Open hole Natural Development
 Other (describe): _____


Top of lap pipe or reduction in casing: _____ feet. ***If telescoped or more than one screen, describe on next page***

RECEIVED
 APR 07 2014
 BY: OLWR

C 176

The sketch below only required for water wells

If well telescopes, show depths on sketch.

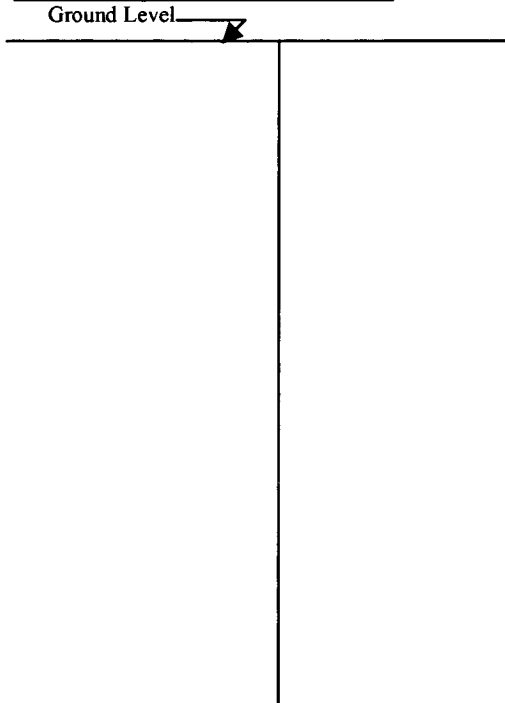


Description of formations encountered must be provided for all wells and boreholes, unless specifically exempted by regulations

Description of Formations Encountered	From (depth)	To (depth)
	Ground Level	
Lt gr and Red s&cl	0	18
Lt gr ss&a	18	28
Lt Br ss	28	80

If more than one screen, show location of each on sketch

Sketch the property layout and include the following: 1) the well location; 2) any permanent structures on the property that may aid in locating the well; 3) any roads, power lines, or other items that may aid in locating the property and the well; 4) a north arrow.

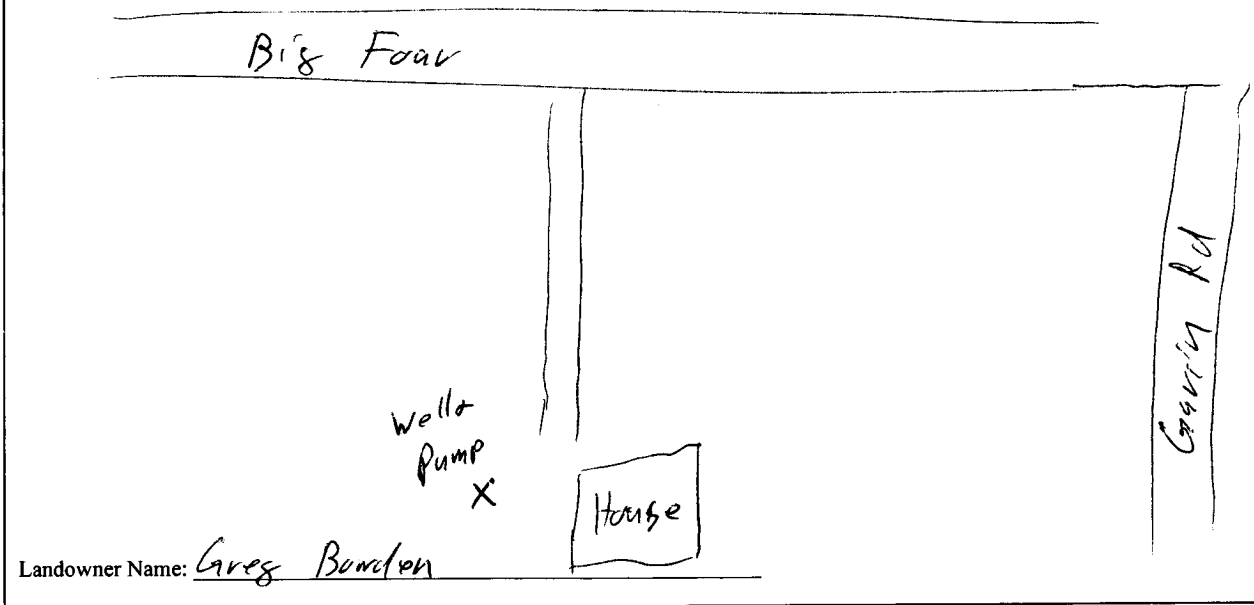

Form: OLWR-SWR-1A

I certify that the well/borehole was drilled, constructed, and completed in accordance with all applicable requirements of the Mississippi Department of Environmental Quality and the Mississippi Department of Health regulations, if applicable, and state laws.

Heath S. Williams 0-790 3-24-14

Print Name of Responsible Licensee and License No. Date

[Handwritten Signature]

Signature of Licensee

RECEIVED

APR 07 2014

BY: OLWR

STATE WELL REPORT

Part 2

Pump Installer's Completion Report
 Mississippi Department of Environmental Quality
 Office of Land and Water Resources
 P.O. Box 10631
 Jackson, MS 39289-0631
 (601)961-5210
 (601)354-6938 (fax)

County: _____
 Permit #: _____
 Driller: _____
 Date completed: _____
Copy information from block on Part 1

For Office Use Only:

Aquifer: _____
 Well #: C 176
 Elevation: _____

This part of the report must be completed by a licensed water well contractor or a licensed pump installer. A copy of Part 1 of the report must be attached and both parts filed with the Department at the above address within 30 days of well completion.

Well Owner Information	Well Location
Owner Name: <u>Greg Bowden</u>	Latitude: <u>30° 51' 17"</u> Longitude: <u>89° 41' 48"</u>
Mailing Address: <u>Big Four Road</u>	Method of Lat/Long (check one): Conventional Survey _____
<u>Wiggins MS 39577</u>	USGS quad _____, Hand-held GPS <input checked="" type="checkbox"/> , Survey-grade GPS _____
City State Zip Code	<u>SE ¼ SW ¼ Sec 22 T 25 R 11W</u>
Telephone No. <u>(251) 751-5961</u>	Distance Direction Nearest Town
	<u>4.5 Miles East of Wiggins</u>

Pump Type Circle one	Power Type Circle one
Air Lift Jet <input type="checkbox"/> <u>Submersible</u>	Diesel Engine Gasoline Engine Natural Gas
Bucket Piston <input type="checkbox"/> Turbine <input type="checkbox"/>	<u>Electric Motor</u> Hand <input type="checkbox"/> Tractor PTO <input type="checkbox"/>
Centrifugal Rotary <input type="checkbox"/> Flowing Well <input type="checkbox"/>	Windmill Other (specify): _____
Other (specify): _____	Horse Power Rating of Motor: <u>1</u>
Date Pump Installed: <u>10-18-13</u>	Setting Depth: <u>60'</u> feet
Rated Pump Capacity: <u>19</u> Gallons Per Minute	Number of Stages: <u>9</u>

Pump Test Data	Method of Measuring Water Level Circle one
Date Well Tested: <u>10-18-13</u>	Air Line Electric Measuring Line <u>Steel Tape</u>
Static Water Level (A): _____ Feet Below Land Surface	Other (specify): _____
Pumping Water Level (B): _____ Feet Below Land Surface	For flowing well, measured shut in head: _____ feet
Drawdown [(B) - (A)]: _____ Feet Below Land Surface	Well yielded _____ GPM with a drawdown of _____ feet after _____ hours of pumping
Test Pumping Rate: <u>20</u> Gallons Per Minute	
Duration of Pump Test (minimum 4 hours): <u>4</u> hours	

I HEREBY CERTIFY that the above statements are true to the best of my knowledge.

Heath S. Williams 0-790
 Print Name of Pump Installer and License No. (if applicable)

[Signature]
 Signature of Pump Installer

RECEIVED
 Form: OLWR-SWR-1B

APR 09 2014

BY: OLWR