

Stone  
C 2001  
12-8-75

MISSISSIPPI  
 BOARD OF WATER COMMISSIONERS  
 416 North State Street  
 Jackson, Mississippi 39201

WATER WELL DRILLERS LOG

12-8 1975 Pamell Anderson Stone  
 date well completed firm name county well located

LANDOWNER:  
George Weaver  
 (mailing address)

WELL LOCATION:  
 sec 25 T 2 S R 11 W  
5 miles NE of Wiggins  
 (distance) (direction) (nearest town)

WELL PURPOSE: HOME  
 (home, irrigation, municipal, industrial)

WELL COMPLETION DATA:

(1) diameter (inches) 2"  
 (2) total depth (feet) 122'  
 (3) static water level (feet) 58 below above top of ground.  
 (4) casing Plastic, 117'  
 (material) (depth)  
 (size) If telescope see back.  
 (5) screen 5' 117'  
 (length) (depth to top)  
2" Plastic  
 (size) (material)  
 (6) pump 1 7  
 (HP) (yield gpm)  
Elect  
 (type power)  
 (7) electric log no  
 (yes or no)  
 (organization running log)  
 (8) how well bottom plugged Plugged


description of formations encountered	from	to
<u>Top Soil</u>	<u>0</u>	<u>4</u>
<u>Red Clay</u>	<u>4</u>	<u>14</u>
<u>Coarse Sand</u>	<u>14</u>	<u>80</u>
<u>Sandy Clay</u>	<u>80</u>	<u>105</u>
<u>Coarse Sand</u>	<u>105</u>	<u>122</u>

DRILLERS REMARKS:

RECORDED  
 INDEXED  
 JAN 5 1976  
 MISS. BD. OF WATER COMMISSIONERS

If well telescopes please sketch and show depths.

GROUND LEVEL

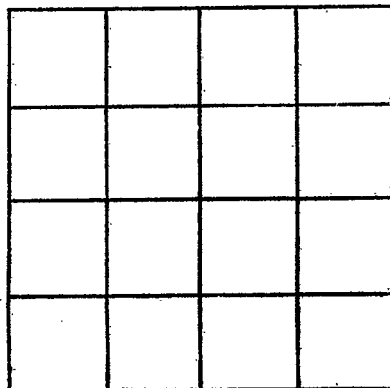

SECTION \_\_\_\_\_

Please indicate well location X.

ADDITIONAL INFORMATION

If more than one screen, show locations of each on sketch.