

Need address & distance to nearest town.

STONE
C 2004
4-16-76

MISSISSIPPI
BOARD OF WATER COMMISSIONERS
416 North State Street
130 Jackson, Mississippi 39201

WATER WELL DRILLERS LOG

4-16-1976 date well completed
130 firm name
Stone county well located

LANDOWNER:
Donny Allison
(mailing address)


description of formations encountered	depth	
	from	to
Top Soil	0	4
Red Sand	4	22
Coarse Sand	22	80

WELL LOCATION:
sec 8 T 2 R 11 E S W
miles (distance) of (direction) of (nearest town)

WELL PURPOSE: HOME
(home; irrigation; municipal; industrial)

- WELL COMPLETION DATA:
- (1) diameter (inches) 2 1/2
 - (2) total depth (feet) 80
 - (3) static water level (feet) 15 below top of ground
 - (4) casing Plastic 75' (material) (depth)
 - (5) screen 5' 75' (length) (depth to top)
2" Plastic (size) (material)
 - (6) pump 1/2 (HP) 12 (yield gpm)
E best (type power)
 - (7) electric log no (yes or no)
 - (8) how well bottom plugged capped

DRILLERS REMARKS:

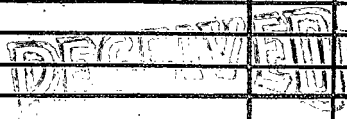

MAY 5 1976

