

MISS. Bd. OF WATER COMMISSIONERS
STONE
 C. 2005
 4-21-76

MISSISSIPPI
 BOARD OF WATER COMMISSIONERS
 416 North State Street
 Jackson, Mississippi 39201

WATER WELL DRILLERS LOG


2 *Stone*
 firm name county well located

date well completed

firm name

county well located

LANDOWNER:	description of formations encountered	from	to
<i>Don Ornel</i>			
(mailing address)	<i>Top Soil</i>	<i>8'</i>	<i>11'</i>
WELL LOCATION:	<i>Red Clay</i>	<i>11'</i>	<i>44'</i>
sec. <i>31</i> T. <i>2</i> S. R. <i>11</i> W.	<i>Fine Sand</i>	<i>44'</i>	<i>81'</i>
<i>2</i> miles <i>S</i> of <i>Wiggins</i>	<i>Coarse Sand</i>	<i>81'</i>	<i>91'</i>
(distance) (direction) (nearest town)			
WELL PURPOSE: <i>HOME</i>			
(home, irrigation, municipal, industrial)			
WELL COMPLETION DATA:			
(1) diameter (inches) <i>2 1/2"</i>			
(2) total depth (feet) <i>91'</i>			
(3) static water level (feet) <i>28'</i> below top of ground.			
(4) casing <i>Plastic</i> <i>86'</i>			
(material) (depth)			
(size) if telescope see back:			
(5) screen <i>3"</i> <i>86'</i>			
(length) (depth to top)			
<i>9"</i> <i>Plastic</i>			
(size) (material)			
(6) pump <i>1</i> <i>10</i>			
(HP) (yield gpm)			
<i>Electric</i>			
(type power)			
(7) electric log <i>no</i>			
(yes or no)			
(organization running log)			
(8) how well bottom plugged <i>Complet</i>			
DRILLERS REMARKS:			

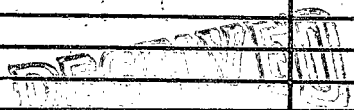

APR 25 1976

MISS. Bd. OF WATER COMMISSIONERS

