

STONE
 C 200
 4-29-76

MISSISSIPPI
 BOARD OF WATER COMMISSIONERS
 416 North State Street
 Jackson, Mississippi 39201

WATER WELL DRILLERS LOG

4-29-76
 date well completed

130
 76 *Parrell Anderson*
 firm name

Stone
 county well located

LANDOWNER:	description of formations encountered	from	to
<i>Gerald Milles</i>	<i>Top Soil</i>	<i>0</i>	<i>4</i>
(mailing address)	<i>Red clay</i>	<i>4</i>	<i>22</i>
WELL LOCATION:	<i>Hard Sand</i>	<i>22</i>	<i>48</i>
sec. <i>30</i> T. <i>2</i> R. <i>11</i> E	<i>Coarse Sand</i>	<i>48</i>	<i>100</i>
<i>2</i> S. <i>5</i> W			
(distance) miles (direction) of (nearest town)			
WELL PURPOSE: <i>IRRIGATION</i>			
(home, irrigation, municipal, industrial)			
WELL COMPLETION DATA:			
(1) diameter (inches) <i>4</i>			
(2) total depth (feet) <i>100</i>			
(3) static water level (feet) <i>35</i> below top of ground.			
(4) casing <i>Plastic 90'</i> (material) (depth)			
(size) If telescope see back.			
(5) screen <i>10' 90'</i> (length) (depth to top)			
<i>2" Plastic</i> (size) (material)			
(6) pump <i>1 37</i> (HP) (yield gpm)			
<i>Elect</i> (type power)			
(7) electric log <i>no</i> (yes or no)			
(organization running log)			
(8) how well bottom plugged <i>Bar with valve</i>			
DRILLERS REMARKS:			


DRILLERS

MAY 5 1976

MISS. BD. OF WATER COMMISSIONERS

If well telescopes please sketch and show depths.

GROUND LEVEL

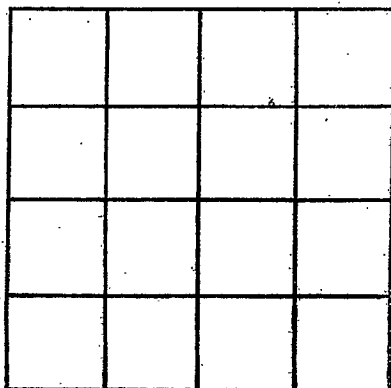

SECTION _____

Please indicate well location X.

ADDITIONAL INFORMATION

If more than one screen,
show locations of each on sketch.