

Stone  
 C 2009  
 8/18/76

MISSISSIPPI  
 BOARD OF WATER COMMISSIONERS  
 416 North State Street  
 Jackson, Mississippi 39201

WATER WELL DRILLERS LOG

8-18 1976 Pernell Anderson Stone  
 date well completed firm name county well located


LANDOWNER:	description of formations encountered	from	to
<u>Edsel Taylor</u>	<u>Top Soil</u>	<u>0</u>	<u>3</u>
(mailing address)	<u>Red Clay</u>	<u>3</u>	<u>38</u>
WELL LOCATION:	<u>Thin Sand</u>	<u>38</u>	<u>65</u>
sec. <u>4</u> T. <u>2</u> S. R. <u>11</u> W. <u>4</u> miles <u>NE</u> of <u>Wiggins</u> (distance) (direction) (nearest town)			
WELL PURPOSE: <u>HOME</u> (home, irrigation, municipal, industrial)			
WELL COMPLETION DATA:			
(1) diameter (inches) <u>2"</u>			
(2) total depth (feet) <u>65'</u>			
(3) static water level (feet) <u>28'</u> below above top of ground.			
(4) casing <u>Plastic</u> , <u>60'</u> (material) (depth)			
_____ if telescope see back. (size)			
(5) screen <u>5'</u> , <u>60'</u> (length) (depth to top)			
<u>2"</u> , <u>Plastic</u> (size) (material)			
(6) pump <u>1</u> , <u>8</u> (HP) (yield gpm)			
<u>Elect</u> (type power)			
(7) electric log <u>no</u> (yes or no)			
_____ (organization running log)			
(8) how well bottom plugged <u>Capped</u>			
DRILLERS REMARKS:			

RECEIVED

SEP - 7 1976

If well telescopes please sketch and show depths.

GROUND LEVEL

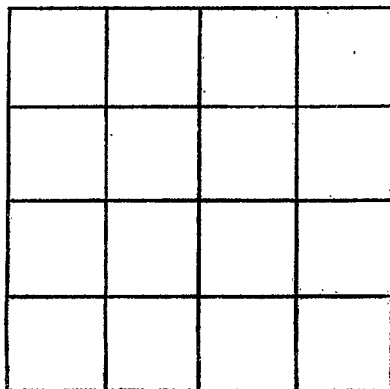

SECTION \_\_\_\_\_

Please indicate well location X.

ADDITIONAL INFORMATION

If more than one screen,  
show locations of each on sketch.