

Stone
 C 200
 8/24/76

MISSISSIPPI
 BOARD OF WATER COMMISSIONERS
 416 North State Street
 Jackson, Mississippi 39201

WATER WELL DRILLERS LOG

8-24 1976 Paul Anderson Stone
 date well completed firm name county well located

LANDOWNER:	description of formations encountered	from	to
<u>Jrley Williams</u> (mailing address)			
	<u>Sandy Clay</u>	<u>4'</u>	<u>32'</u>
	<u>Coarse Sand</u>	<u>32'</u>	<u>89'</u>
	<u>Clay</u>	<u>89'</u>	<u>94'</u>
	<u>Coarse Sand</u>	<u>94'</u>	<u>120'</u>
WELL LOCATION: sec. <u>33</u> T <u>2</u> S R <u>11</u> E W <u>1</u> <u>3</u> miles <u>SE</u> of <u>Wright</u> (distance) (direction) (nearest town)			
WELL PURPOSE: <u>HOME</u> (home, irrigation, municipal, industrial)			
WELL COMPLETION DATA:			
(1) diameter (inches) <u>4"</u>			
(2) total depth (feet) <u>120'</u>			
(3) static water level (feet) <u>82'</u> below top of ground.			
(4) casing <u>Plastic</u> , <u>115'</u> (material) (depth)			
(size) If telescope see back.			
(5) screen <u>5"</u> , <u>115'</u> (length) (depth to top)			
<u>14"</u> , <u>Plastic</u> (size) (material)			
(6) pump <u>1</u> <u>22</u> (HP) (yield gpm)			
<u>Elect</u> (type power)			
(7) electric log <u>no</u> (yes or no)			
(organization running log)			
(8) how well bottom plugged <u>Barrow Valve</u>			
DRILLERS REMARKS:			


RECEIVED

SEP - 7 1976

MISS. BD. OF WATER COMMISSIONERS

If well telescopes please sketch and show depths.

GROUND LEVEL

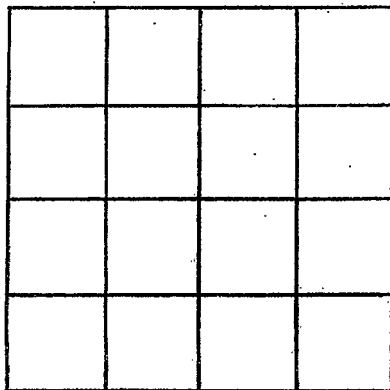

SECTION _____

Please indicate well location X.

ADDITIONAL INFORMATION

If more than one screen,
show locations of each on sketch.