

Stone
 C 200
 1-26-77

MISSISSIPPI
 BOARD OF WATER COMMISSIONERS
 416 North State Street
 132 Jackson, Mississippi 39201

WATER WELL DRILLERS LOG

1-26-77 date well completed
 13277 Pamell Anderson firm name
 Stone county well located

LANDOWNER: Verden Taylor
 (mailing address)

description of formations encountered	from	to
Top Soil	0	2
Fine Sand	2	47
Coarse Sand	47	65

WELL LOCATION:
 sec. 21 T 2 S R 11 W
 3 miles E of Wagon
 (distance) (direction) (nearest town)

WELL PURPOSE: HOME
 (home, irrigation, municipal, industrial)

- WELL COMPLETION DATA:
- (1) diameter (inches) 2"
 - (2) total depth (feet) 65'
 - (3) static water level (feet) 28' below top of ground
 - (4) casing (material) Plastic, (depth) 60'
 - (5) screen (length) 5', (depth to top) 60'
 - (6) pump (HP) 1, (yield gpm) 10
 - (7) electric log (yes or no) No

(size) if telescope see back.

(size) (material) 5" Plastic

(type power) C. Vert

(organization running log)

(8) how well bottom plugged
 Capped


DRILLERS REMARKS:

RECEIVED

FEB - 1 1977

If well telescopes please sketch and show depths.

GROUND LEVEL

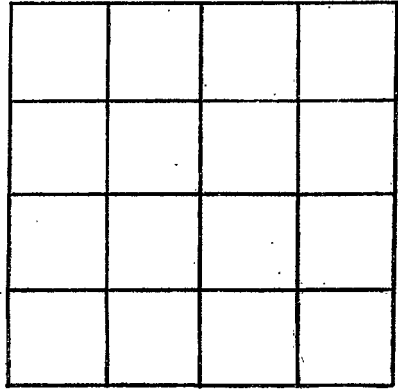

SECTION _____

Please indicate well location X.

ADDITIONAL INFORMATION

If more than one screen, show locations of each on sketch.