

Stone  
 C 2002  
 1-27-77

MISSISSIPPI  
 BOARD OF WATER COMMISSIONERS  
 416 North State Street  
 Jackson, Mississippi 39201

132


WATER WELL DRILLERS LOG

1-27-77 date well completed 1977 firm name Stone county well located

LANDOWNER:	description of formations encountered	from	to
Bud Madoux	Top Soil	0	3
(mailing address)	Clay	3	18
WELL LOCATION:	Fine Sand	18	91
sec. 2 T 2 S R 11 W	Coarse Sand	91	95
2 miles N of 25 legs in			
(distance) (direction) (nearest town)			
WELL PURPOSE: HOME			
(home, irrigation, municipal, industrial)			
WELL COMPLETION DATA:			
(1) diameter (Inches) 2"			
(2) total depth (feet) 95'			
(3) static water level (feet) 24' below top of ground			
(4) casing (material) Plastic, (depth) 96'			
(size) If telescope see back.			
(5) screen (length) 5' (depth to top) 90'			
(size) 2" (material) Plastic			
(6) pump (HP) 1 (yield gpm) 10			
(type power) Elect			
(7) electric log (yes or no) no			
(organization running log)			
(8) how well bottom plugged			
DRILLERS REMARKS:			

If well telescopes please sketch and show depths.

GROUND LEVEL

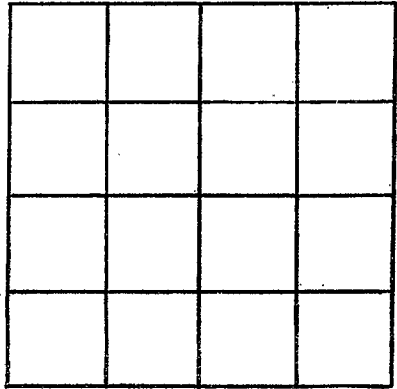

SECTION \_\_\_\_\_

Please indicate well location X.

ADDITIONAL INFORMATION

If more than one screen, show locations of each on sketch.