

Stone  
C 203  
3-2-77

MISSISSIPPI  
 BOARD OF WATER COMMISSIONERS  
 416 North State Street  
 132 Jackson, Mississippi 39201

WATER WELL DRILLERS LOG

3-2 1977 Stone firm name Stone county well located

LANDOWNER:  
Jessie Brooks  
 (mailing address)

WELL LOCATION:  
 sec 31 T 2 S R 11 W  
1 miles S of Wiggins  
 (distance) (direction) (nearest town)

WELL PURPOSE: HOME  
 (home, irrigation, municipal, industrial)

WELL COMPLETION DATA:

(1) diameter (inches) 2"

(2) total depth (feet) 123

(3) static water level (feet) 38' below above top of ground.

(4) casing Plaster, 118'  
 (material) (depth)

(size) if telescope see back.

(5) screen 5', 118'  
 (length) (depth to top)

2', Plaster  
 (size) (material)

(6) pump 1, 10  
 (HP) (yield gpm)

Elect  
 (type power)

(7) electric log no  
 (yes or no)

(organization running log)

(8) how well bottom plugged Copper

description of formations encountered	from	to
<u>Top Soil</u>	<u>0</u>	<u>2</u>
<u>Red Clay</u>	<u>2</u>	<u>20</u>
<u>Fine Sand</u>	<u>20</u>	<u>44</u>
<u>Clay</u>	<u>44</u>	<u>52</u>
<u>Fine Sand</u>	<u>52</u>	<u>110</u>
<u>Coarse Sand</u>	<u>110</u>	<u>123</u>


**RECEIVED**  
 APR 7 1977

MISS. Bd. OF WATER COMM.

DRILLERS REMARKS:

If well telescopes please sketch and show depths.

GROUND LEVEL

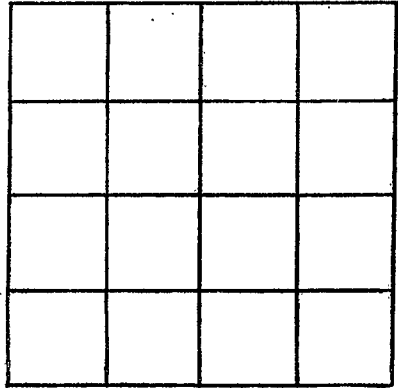

SECTION \_\_\_\_\_

Please indicate well location X.

ADDITIONAL INFORMATION

If more than one screen, show locations of each on sketch.