

Stone
 C 2014
 4-1-77

MISSISSIPPI
 BOARD OF WATER COMMISSIONERS
 416 North State Street
 130 Jackson, Mississippi 39201

WATER WELL DRILLERS LOG


4-1 1977 Panell Anderson Stone
 date well completed firm name county well located

LANDOWNER:	description of formations encountered	from	to
Jessie Rhodes	Top Soil	0	3
(mailing address)	Red Clay	3	24
WELL LOCATION:	Fine Sand	24	68
sec. <u>31</u> T <u>2</u> N R <u>11</u> W	Coarse Sand	68	125
<u>1</u> miles <u>S</u> of <u>Wiggins</u>			
(distance) (direction) (nearest town)			
WELL PURPOSE: <u>Ind.</u>			
(home, irrigation, municipal, industrial)			
WELL COMPLETION DATA:			
(1) diameter (inches) <u>2"</u>			
(2) total depth (feet) <u>125</u>			
(3) static water level (feet) <u>43</u> below top of ground			
(4) casing <u>Plastic, 120'</u>			
(material) (depth)			
(size) If telescope see back.			
(5) screen <u>5' 120"</u>			
(length) (depth to top)			
<u>2</u> <u>Plastic</u>			
(size) (material)			
(6) pump <u>1</u> <u>10</u>			
(HP) (yield gpm)			
<u>Elect</u>			
(type power)			
(7) electric log <u>no</u>			
(yes or no)			
(organization running log)			
(8) how well bottom plugged <u>Capped</u>			
DRILLERS REMARKS:			

RECEIVED
 MAY 9 1977

If well telescopes please sketch and show depths.

GROUND LEVEL

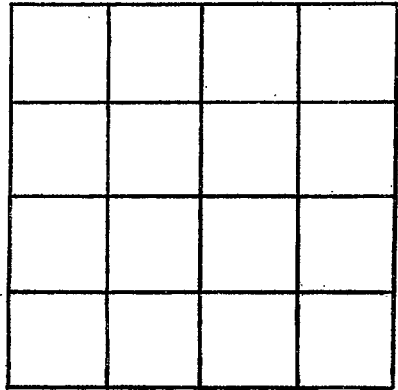

SECTION _____

Please indicate well location X.

ADDITIONAL INFORMATION

If more than one screen,
show locations of each on sketch.