

STONE  
C 2015  
5-13-77

MISSISSIPPI  
BOARD OF WATER COMMISSIONERS  
416 North State Street  
132 Jackson, Mississippi 39201

WATER WELL DRILLERS LOG

5-13 date well completed  
1977 Parnell Anderson firm name  
Stone county well located

LANDOWNER: Larry Oreal  
description of formations encountered: Topsoil from 0 to 2  
Course Sand 2 to 57  
(mailing address)

WELL LOCATION:  
sec. 8 T 2 N R 11 E  
S W  
2 miles NE of W. Egg  
(distance) (direction) (nearest town)

WELL PURPOSE: 100 MILE  
(home, irrigation, municipal, industrial)

WELL COMPLETION DATA:  
(1) diameter (inches) 2"  
(2) total depth (feet) 57  
(3) static water level (feet) 12' below top of ground  
(4) casing (material) Plastic (depth) 52  
(size) If telescope see back.  
(5) screen (length) 5' (depth to top) 52'  
(size) 2" (material) Plastic  
(6) pump 1 (HP) 8 (yield gpm)  
Elect (type power)  
(7) electric log no (yes or no)  
(organization running log)  
(8) how well bottom plugged Caprock


DRILLERS REMARKS:

RECEIVED  
JUN 13 1977

MISS. BD. OF WATER COMM.

If well telescopes please sketch and show depths.

GROUND LEVEL

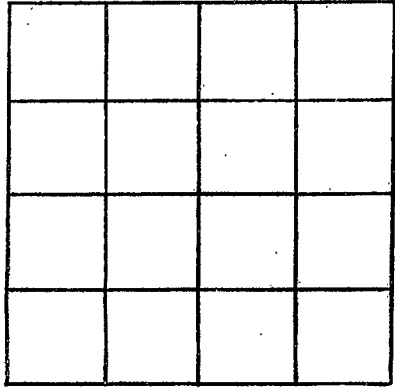

SECTION \_\_\_\_\_

Please indicate well location X.

ADDITIONAL INFORMATION

If more than one screen,  
show locations of each on sketch.