

STONE
 C 2016
 5/16/77

MISSISSIPPI
 BOARD OF WATER COMMISSIONERS
 416 North State Street
 132 Jackson, Mississippi 39201

WATER WELL DRILLERS LOG

5-16 1977 Parnell Anderson Stone
 date well completed firm name county well located

LANDOWNER: Jonny Smith
 description of formations encountered: Top Soil from 0 to 2
Coarse Sand 2 to 64
 (mailing address)

WELL LOCATION:
 sec. 9 T. 2 N. R. 11 E.
3 miles NE of Wiggins
 (distance) (direction) (nearest town)

WELL PURPOSE: HOME
 (home, irrigation, municipal, industrial)

- WELL COMPLETION DATA:
- (1) diameter (inches) 4"
 - (2) total depth (feet) 64'
 - (3) static water level (feet) 38' below top of ground.
 - (4) casing Plastic 54'
 (material) (depth)
 - (size) If telescope see back.
 - (5) screen 10" 54'
 (length) (depth to top)
 - 4" Plastic
 (size) (material)
 - (6) pump 1/2 22
 (HP) (yield gpm)
 - Elect
 (type power)
 - (7) electric log No
 (yes or no)
 - (organization running log)
 - (8) how well bottom plugged Cap Seal


DRILLERS REMARKS:

RECEIVED
 JUN 13 1977

MISS. BD. OF WATER COMMISSIONERS

If well telescopes please sketch and show depths.

GROUND LEVEL

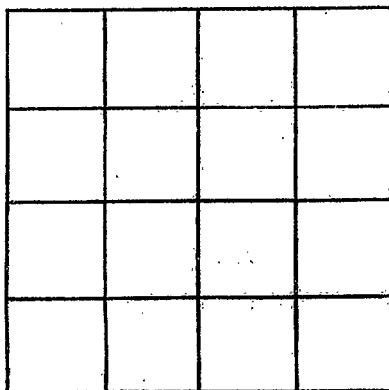

SECTION _____

Please indicate well location X.

ADDITIONAL INFORMATION

If more than one screen,
show locations of each on sketch.