

STONE
C 2077
5-16-77

MISSISSIPPI
BOARD OF WATER COMMISSIONERS
416 North State Street
132 Jackson, Mississippi 39201

WATER WELL DRILLERS LOG

3-16-77 1977 *Parrell Anderson Stone*
date well completed firm name county well located

LANDOWNER: *John Andrews*
description of formations encountered: *Top Soil* from 0 to 2
Clay 2 to 12
(mailing address)

WELL LOCATION:
sec. *17* T. *2* S. R. *11* W.
2 miles *N* of *W. Egg*
(distance) (direction) (nearest town)
Course *South* 12 to 125

WELL PURPOSE: *HOME*
(home, irrigation, municipal, industrial)


- WELL COMPLETION DATA:
- (1) diameter (inches) *2"*
 - (2) total depth (feet) *125'*
 - (3) static water level (feet) *77'* below top of ground.
 - (4) casing *Plastic*, *120'*
(material) (depth)
 - (size) If telescope see back.
 - (5) screen *5'*, *120'*
(length) (depth to top)
 - 2"*, *Plastic*
(size) (material)
 - (6) pump *1*, *2*
(HP) (yield gpm)
 - Elect*
(type power)
 - (7) electric log *no*
(yes or no)
 - (organization running log)
 - (8) how well bottom plugged *Capped*

DRILLERS REMARKS:

RECEIVED
JUN 13 1977

If well telescopes please sketch and show depths.

GROUND LEVEL

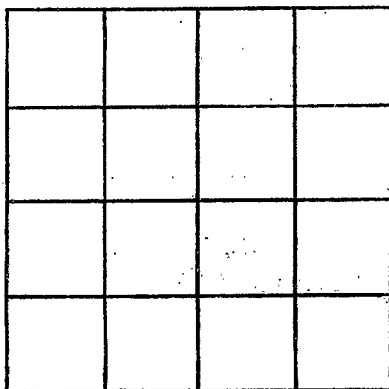

SECTION _____

Please indicate well location X.

ADDITIONAL INFORMATION

If more than one screen,
show locations of each on sketch.