

Stone  
 C 2018  
 5/17/77

MISSISSIPPI  
 BOARD OF WATER COMMISSIONERS  
 416 North State Street  
 132 Jackson, Mississippi 39201

WATER WELL DRILLERS LOG

5-17 1977 *Stone* *Stone*  
 date well completed firm name county well located


LANDOWNER:	description of formations encountered	from	to
David White			
(mailing address)	Fine sand	3	85
WELL LOCATION:	Coarse sand	85	93
sec. 8 T 2 S R 11 E W			
2 1/2 miles N of Wiggins			
(distance) (direction) (nearest town)			
WELL PURPOSE:			
(home, irrigation, municipal, industrial)			
WELL COMPLETION DATA:			
(1) diameter (inches) 2"			
(2) total depth (feet) 93'			
(3) static water level (feet) 16' below top of ground.			
(4) casing Plastic, 88'			
(material) (depth)			
(size) If telescope see back.			
(5) screen 3' 88'			
(length) (depth to top)			
2" Plastic			
(size) (material)			
(6) pump 1 13			
(HP) (yield gpm)			
Elect			
(type power)			
(7) electric log no			
(yes or no)			
(organization running log)			
(8) how well bottom plugged			
Cap			

RECEIVED  
 JUN 13 1977

DRILLERS REMARKS:

If well telescopes please sketch and show depths.

GROUND LEVEL

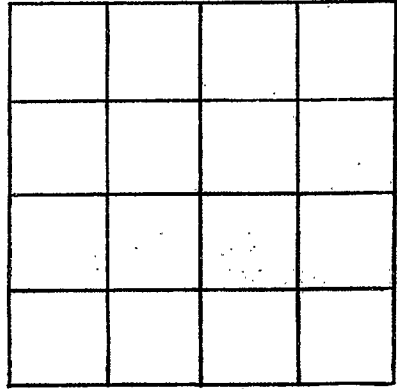

SECTION \_\_\_\_\_

Please indicate well location X.

ADDITIONAL INFORMATION

If more than one screen,  
show locations of each on sketch.